



AIRPORT LAYOUT PLAN FOR TAKOTNA

JULY 2006


DRAWING INDEX


- 1 - COVER SHEET AND INDEX
- 2 - VICINITY MAP AND DATA TABLES
- 3 - EXISTING LAYOUT
- 4 - ULTIMATE LAYOUT
- 5 - EXISTING INNER PORTION OF RW 4 APPROACH SURFACE
- 6 - EXISTING INNER PORTION OF RW 22 APPROACH SURFACE
- 7 - ULTIMATE INNER PORTION OF RW 4 APPROACH SURFACE
- 8 - ULTIMATE INNER PORTION OF RW 22 APPROACH SURFACE
- 9 - AIRPORT AIRSPACE, 14 CFR, PART 77
- 10 - AIRPORT PROPERTY MAP

BY	DATE	REVISIONS
	12/03/13	AS-BUILT TOUCHDOWN ELEVATION
JGL	07/24/13	AS-BUILT PER PROJECT NO 56774

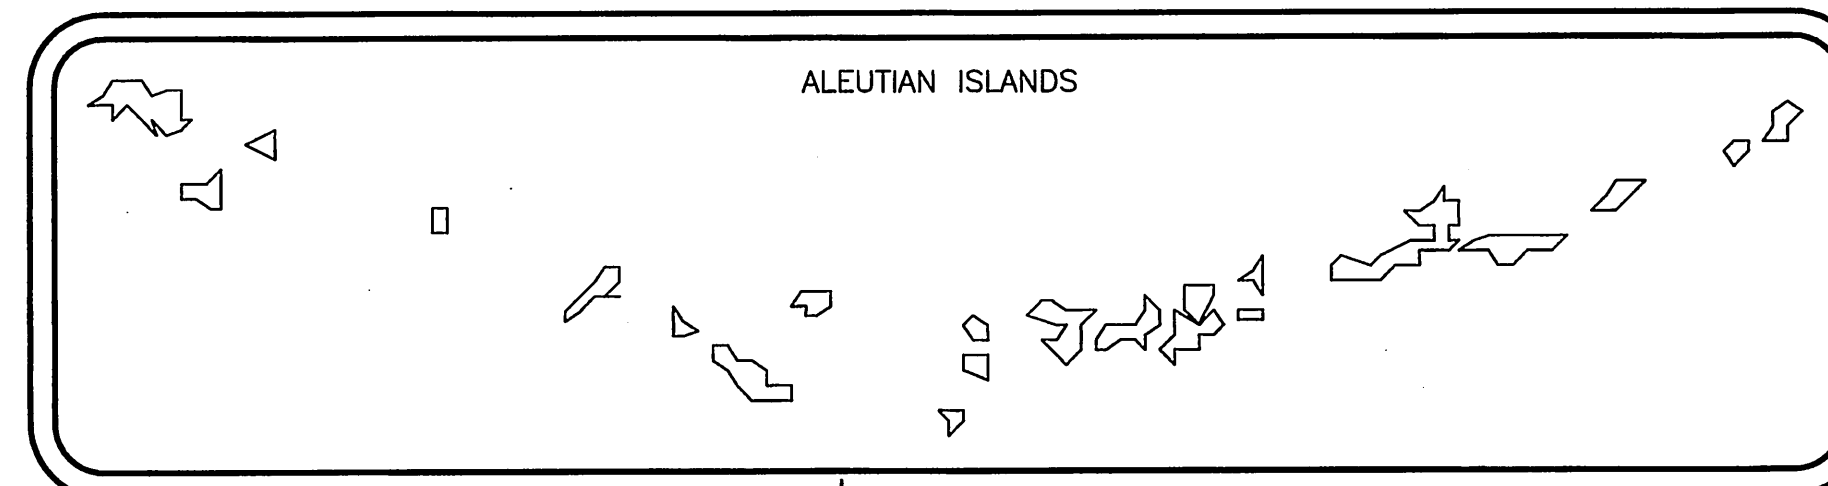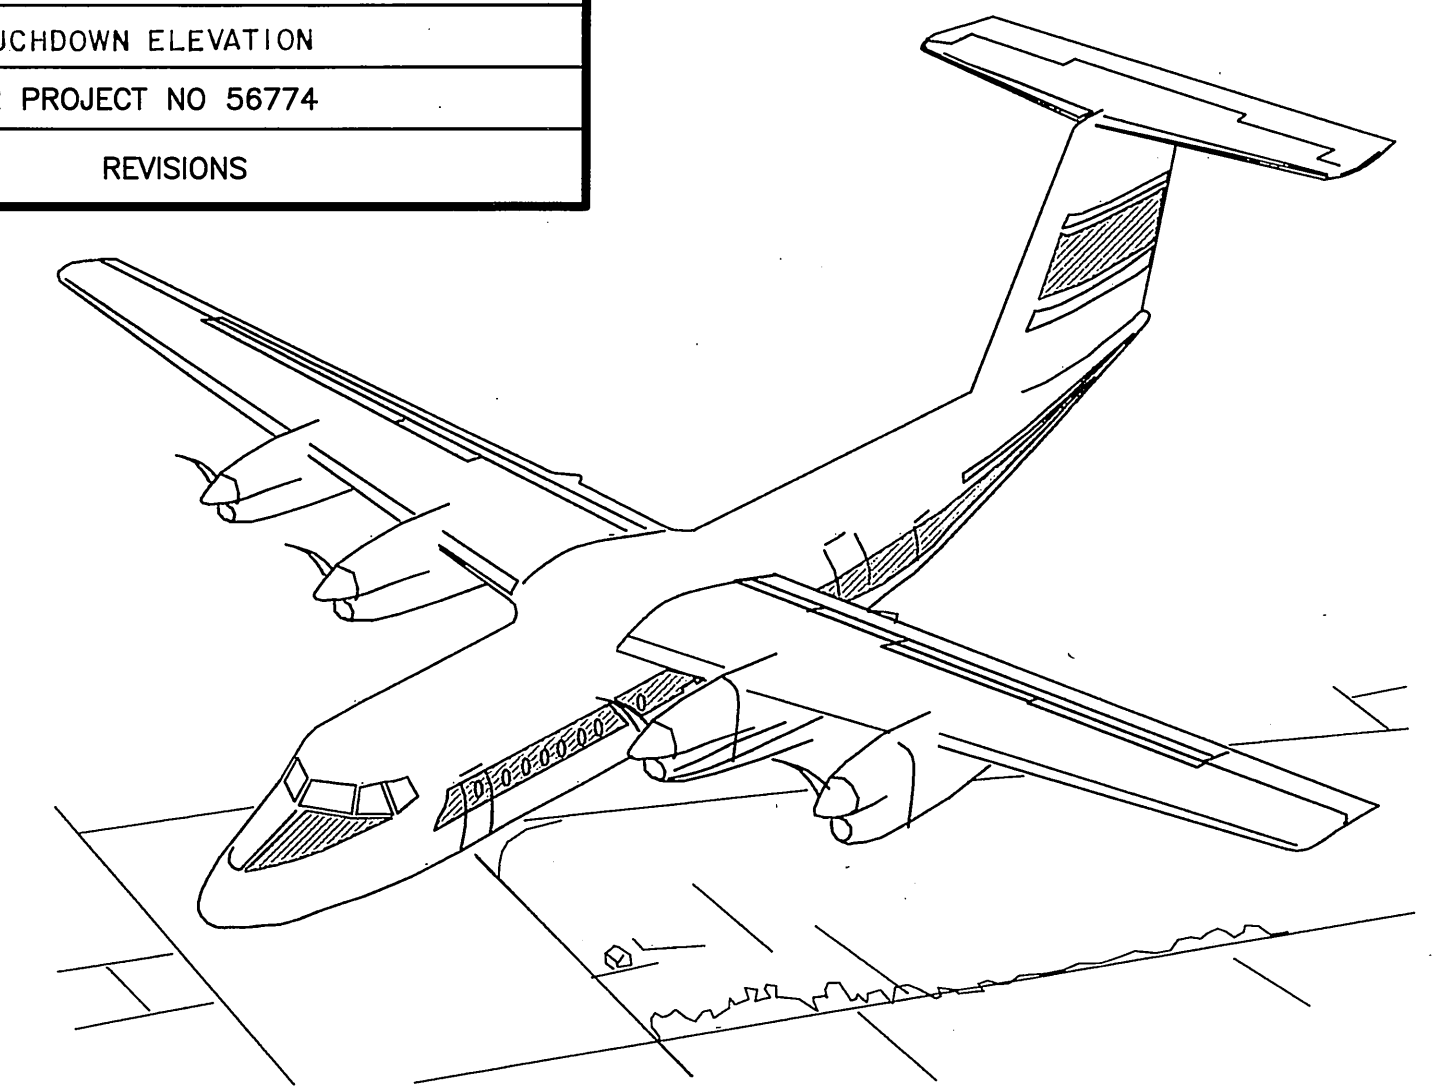


SPONSORED BY
STATE OF ALASKA
DEPARTMENT OF TRANSPORTATION
AND PUBLIC FACILITIES
CENTRAL REGION

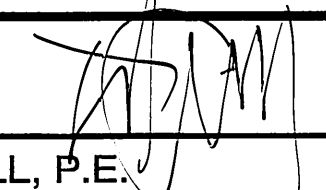CONCUR: 
ROBERT A. CAMPBELL, P.E. REGIONAL PRECONSTRUCTION ENGINEER
DATE: 8/22/06

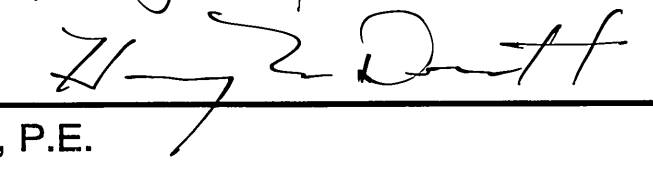APPROVED: 
HARVEY M. DOUTHIT, P.E. DESIGN SECTION CHIEF
DATE: 8/22/2006


AIRPORT LAYOUT PLAN CONDITIONAL APPROVAL
SUBJECT TO ALP APPROVAL LETTER DATED: 8/29/06

By:  DATE: 8/29/06


FAA AIRSPACE REVIEW NUMBER
06-AAL-25 NRA

TAKOTNA
AIRPORT LAYOUT PLAN
SHEET 1 OF 10

User: LWLHELM Jul 18, 2006 - 6:20am
Drawing: 2107072 DOT&PF 140 TAKOTNA\CAD\MACAD2000\CURRENT ALP\112005 UPDATED ALP\YAK-ALP1.DWG - Layout: LAYOUT1
Xrefs: - images

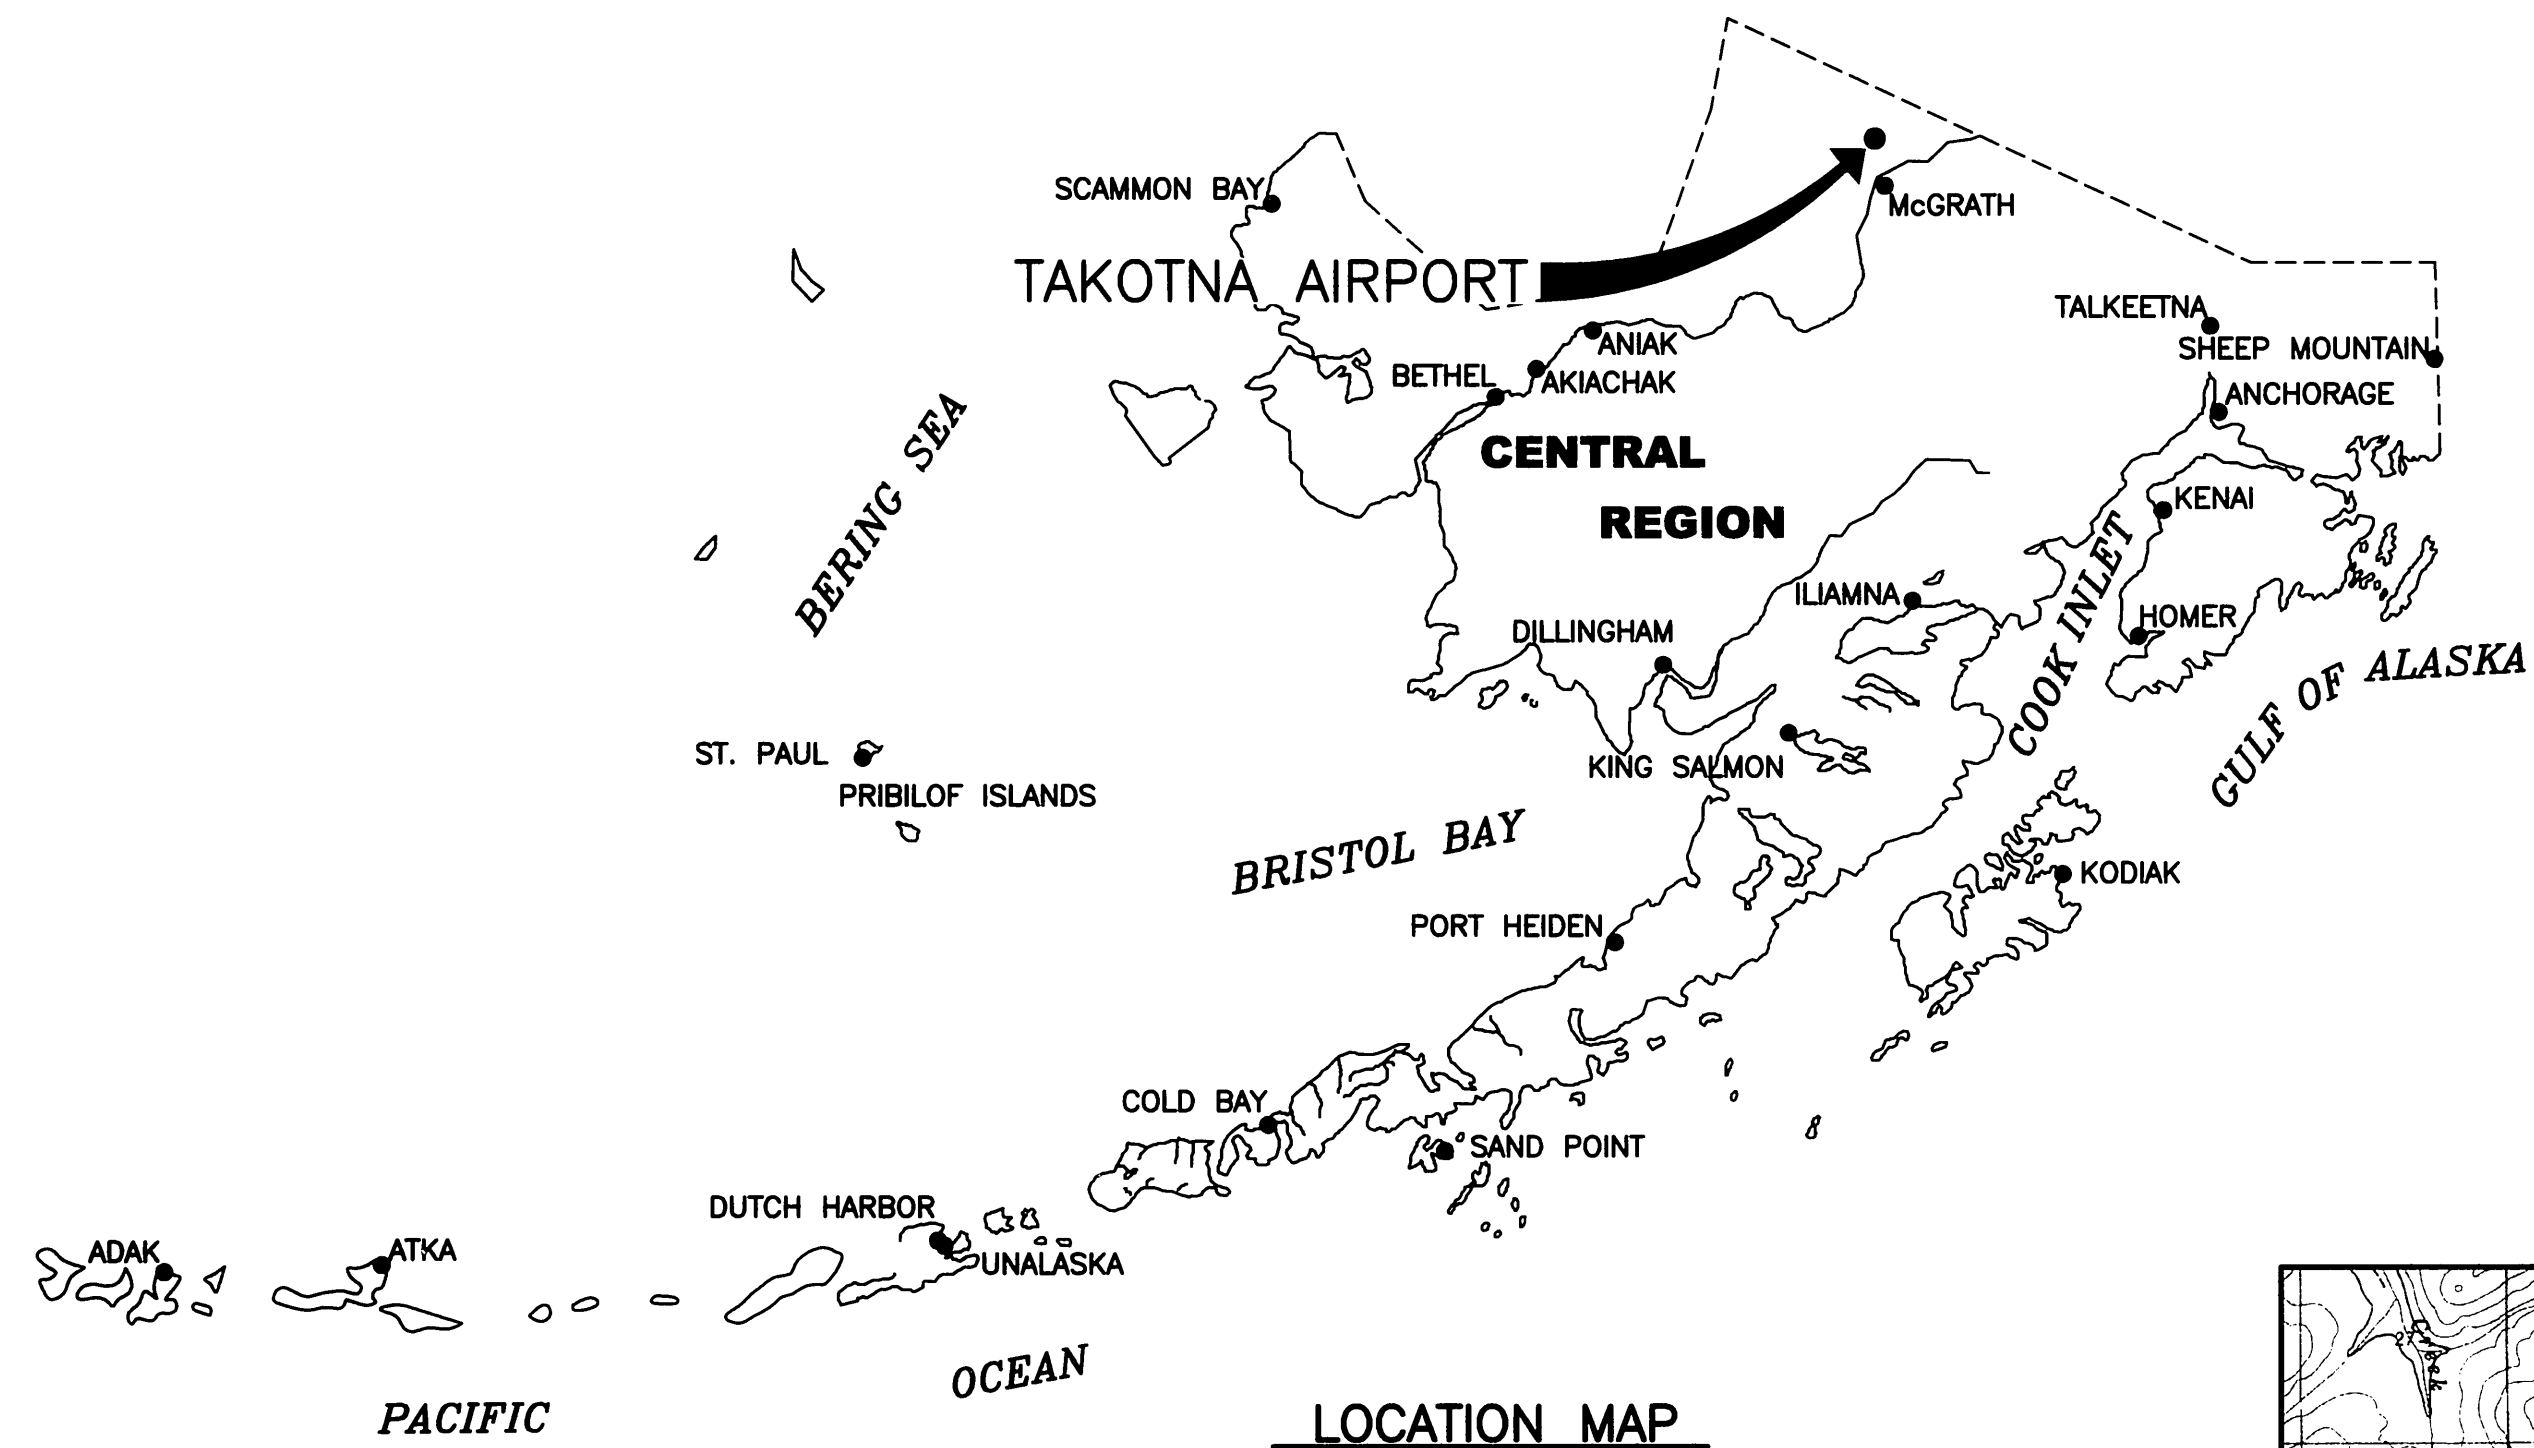


LOCATION MAP

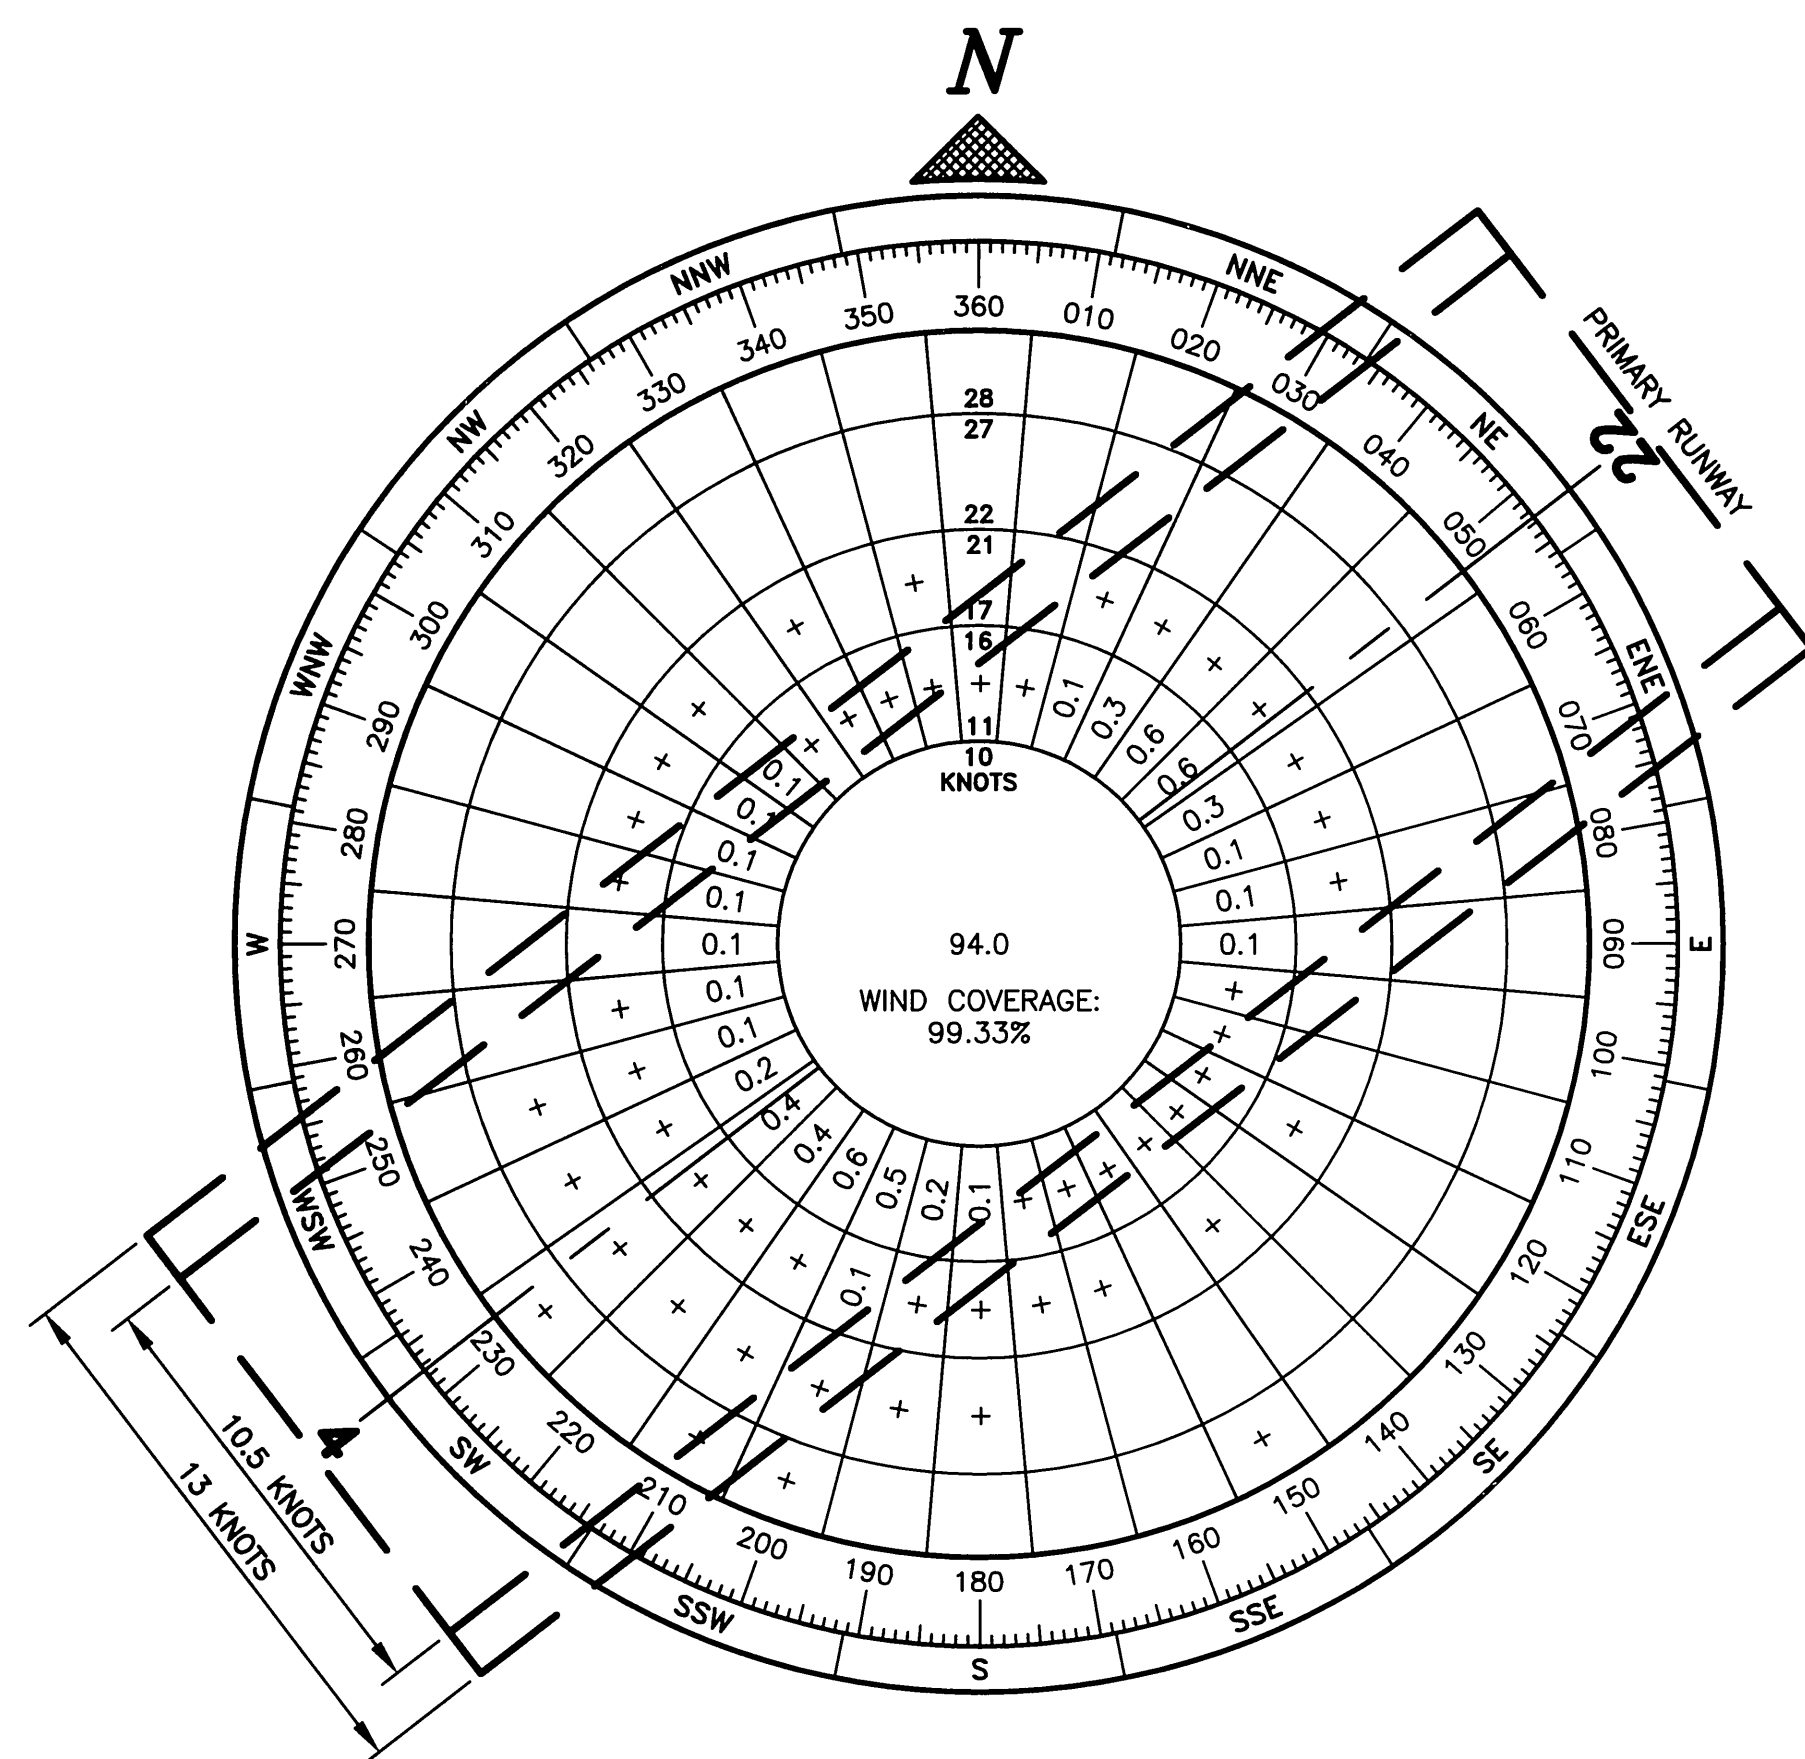


WIND DATA TABLE		
RUNWAY	10.5 kt	13 kt
04/22	99.33%	99.71%

SOURCE:
ALASKA STATE CLIMATE CENTER - TATALINA AIR STATION
REPORT PERIOD: 12/91 - 11/99
SAMPLED IN MILES PER HOUR

LEGEND		
ITEM	EXISTING	ULTIMATE
AIRPORT REFERENCE POINT (A.R.P.)		
ANTENNA		
BLUFF		
BUILDINGS		
BUILDING RESTRICTION LINE		
FENCE		
PAPI		
PROPERTY LINE		
REIL		
ROADWAYS		
ROTATING BEACON		
SHORELINE		
SURVEY MONUMENT		
THRESHOLD MARKERS/LIGHTS		
TOPOGRAPHIC CONTOURS		
TREE (LARGE SINGLE)		
TREELINE		
WIND CONE		
WIND CONE AND SEGMENTED CIRCLE		

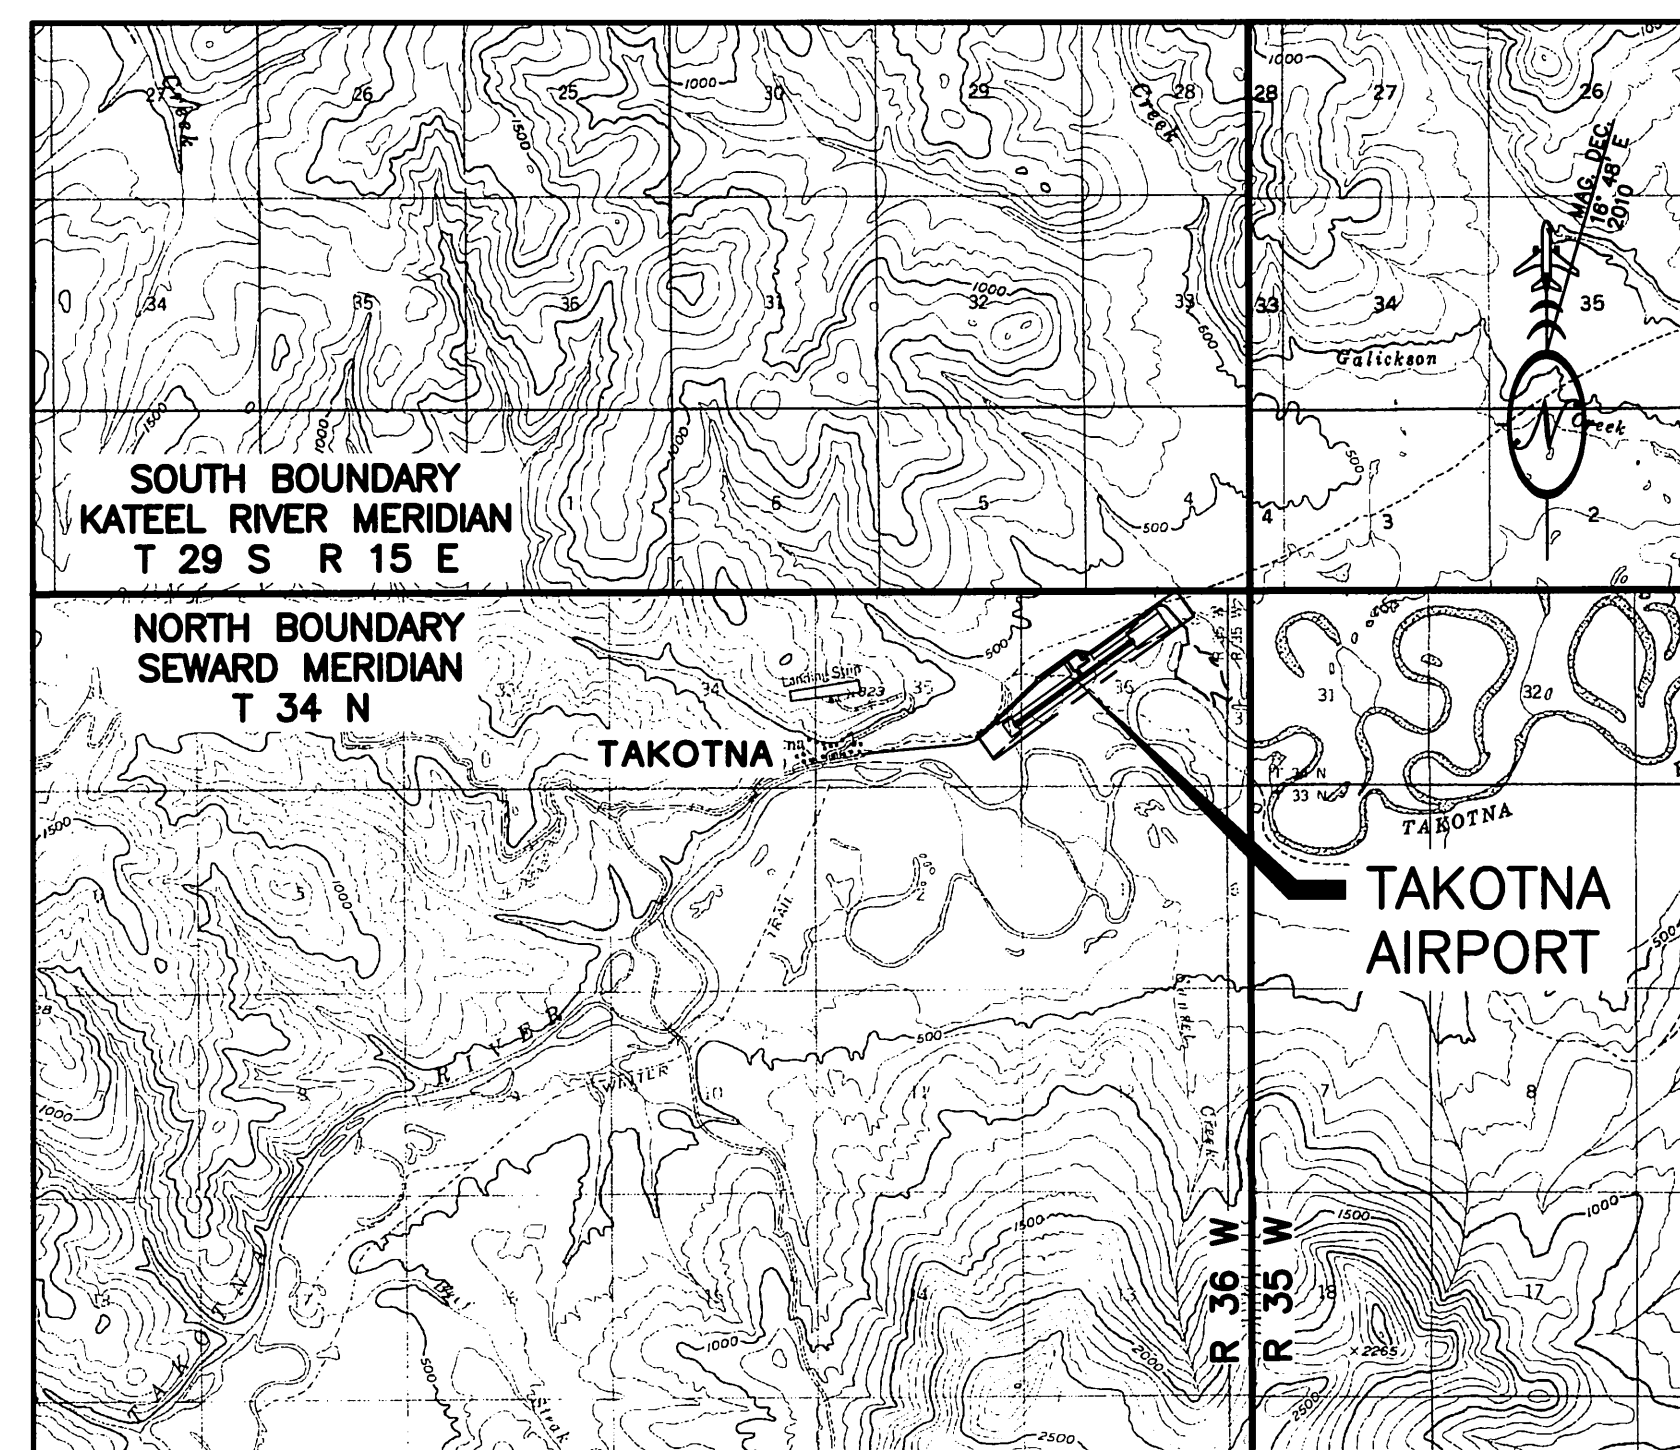

VICINITY MAP

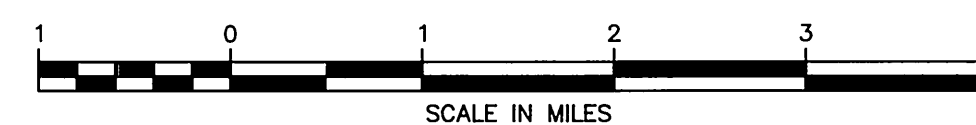

T 034 N, R 036 W, SECS. 35 & 36
SEWARD MERIDIAN
U.S.G.S. IDITAROD (D-1), ALASKA

AIRPORT DATA TABLE		
ITEM	EXISTING	ULTIMATE
ICAO IDENTIFIER	PPCT	PPCT
NATIONAL AIRPORT IDENTIFIER	TCT	TCT
FAA SITE NUMBER	50735.*A	50735.*A
AIRPORT ELEVATION (NAVD88)	422.62'	423.1'
AIRPORT REFERENCE CODE	B-I UTILITY	B-II
MEAN MAX. TEMPERATURE, HOTTEST MONTH (SOURCE: McGRATH)	68.4°	68.4°
AIRPORT AND TERMINAL NAVIGATION AIDS	ROTATING BEACON	GPS, ROTATING BEACON
TAXIWAY LIGHTING/MARKING	MITL/NA	MITL/NA
OBSTRUCTION SURVEY SOURCE & TYPE	NONE	NONE
MAGNETIC DECLINATION, YEAR, RATE OF CHANGE	16°48'E, 2010, 0°17.5'W/YEAR	

RUNWAY 4/22 DATA TABLE		
ITEM	EXISTING	ULTIMATE
FAR PART 77 APPROACH CATEGORY (UTILITY OR OTHER THAN UTILITY)	UTILITY	OTHER THAN UTILITY
RUNWAY APPROACH TYPE (V, NPA, PA)	V/V	NPA/NPA
APPROACH SURFACES	34:1	34:1
VISIBILITY MINIMUM	≥ 1 SM	≥ 1 SM
RUNWAY SURFACE	GRAVEL	GRAVEL
PAVEMENT STRENGTH (SW,DW,DTW,DDTW x1000lbs)	N/A	N/A
AIRCRAFT APPROACH CATEGORY	B	B
AIRPLANE DESIGN GROUP	I	I
MEAN GEODETIC BEARING (TRUE)	N 52°35'52" E	N 52°35'52" E
EFFECTIVE GRADE	0.09%	0.07%
TOUCHDOWN ELEVATION (NAVD88)	423.0' / 423.0'	423.1' / 423.1'
RUNWAY DIMENSIONS	60'x3300'	75'x4000'
RUNWAY SAFETY AREA (RSA) DIMENSIONS	120'x3780'	150'x4600'
RSA LENGTH BEYOND RW END	240' / 240'	300' / 300'
RUNWAY PROTECTION ZONE (RPZ) DIMENSIONS	250'x450'x1000'	500'x700'x1000'
RUNWAY OBJECT FREE AREA (OFA) DIMENSIONS	250'x3780'	500'x4600'
OFA LENGTH BEYOND RW END OR STOPWAY	240' / 240'	300' / 300'
RUNWAY OBSTACLE FREE ZONE (OFZ) DIMENSIONS	250'x3700'	250'x4400'
RUNWAY LIGHTING	MIRL	MIRL
RUNWAY MARKING TYPE	NONE	NONE
RUNWAY VISUAL APPROACH AIDS	NONE	PAPI, REIL

GEOGRAPHIC COORDINATES TABLE (NAD 83)				
ITEM	EXISTING LATITUDE	EXISTING LONGITUDE	ULTIMATE LATITUDE	ULTIMATE LONGITUDE
ARP	62°59'34.6"N	156°01'47.0"W	62°59'36.6"N	156°01'40.9"W
THRESHOLD RW 4	62°59'25.1"N	156°02'16.0"W	62°59'25.1"N	156°02'16.0"W
THRESHOLD RW 22	62°59'44.0"N	156°01'18.0"W	62°59'48.0"N	156°01'05.7"W

MODIFICATION TO STANDARDS/ NON STANDARD CONDITIONS			
DESCRIPTION	STANDARD	EXISTING	ULTIMATE
DISTANCE OF SEWAGE TREATMENT FACILITY FROM RUNWAY	5000'	3000'	3000'

Date Plotted: 3/29/2013 11:17 AM
 Layout Name: ALP02
 File Name: W:\PROJECTS\TAKOTNA ALP\AS-BUILT ALP 2013\ACAD\913000-TAKOTNA-AS-BUILT-ALP02 USKH FILE No. 913000
 Designed By: JGL (USKH, INC.)
 Checked By: ZWS
 Drawn By: MRM



STATE OF ALASKA
DEPARTMENT OF TRANSPORTATION
AND PUBLIC FACILITIES
CENTRAL REGION

TAKOTNA AIRPORT
TAKOTNA, ALASKA
AIRPORT LAYOUT PLAN
VICINITY MAP AND DATA TABLES

DATE:
4/19/2013
SHEET:
2
OF
10

BY	DATE	REVISION
JGL	12/03/13	AS-BUILT TOUCHDOWN ELEVATION
JGL	10/24/13	AS-BUILT PER PROJECT NO 56774




Date Plotted: 3/28/2013 11:17 AM
 Layout Name: APL04
 File Name: \\MCHFILEZ\JOBS\913000\DWGS\913000-TAKOTNA-ALP-AS-BUILT\913000-TAKOTNA-AS-BUILT.dwg
 Drawn By: JGL
 Checked By: ZMS
 Designed By: USKHA, INC.

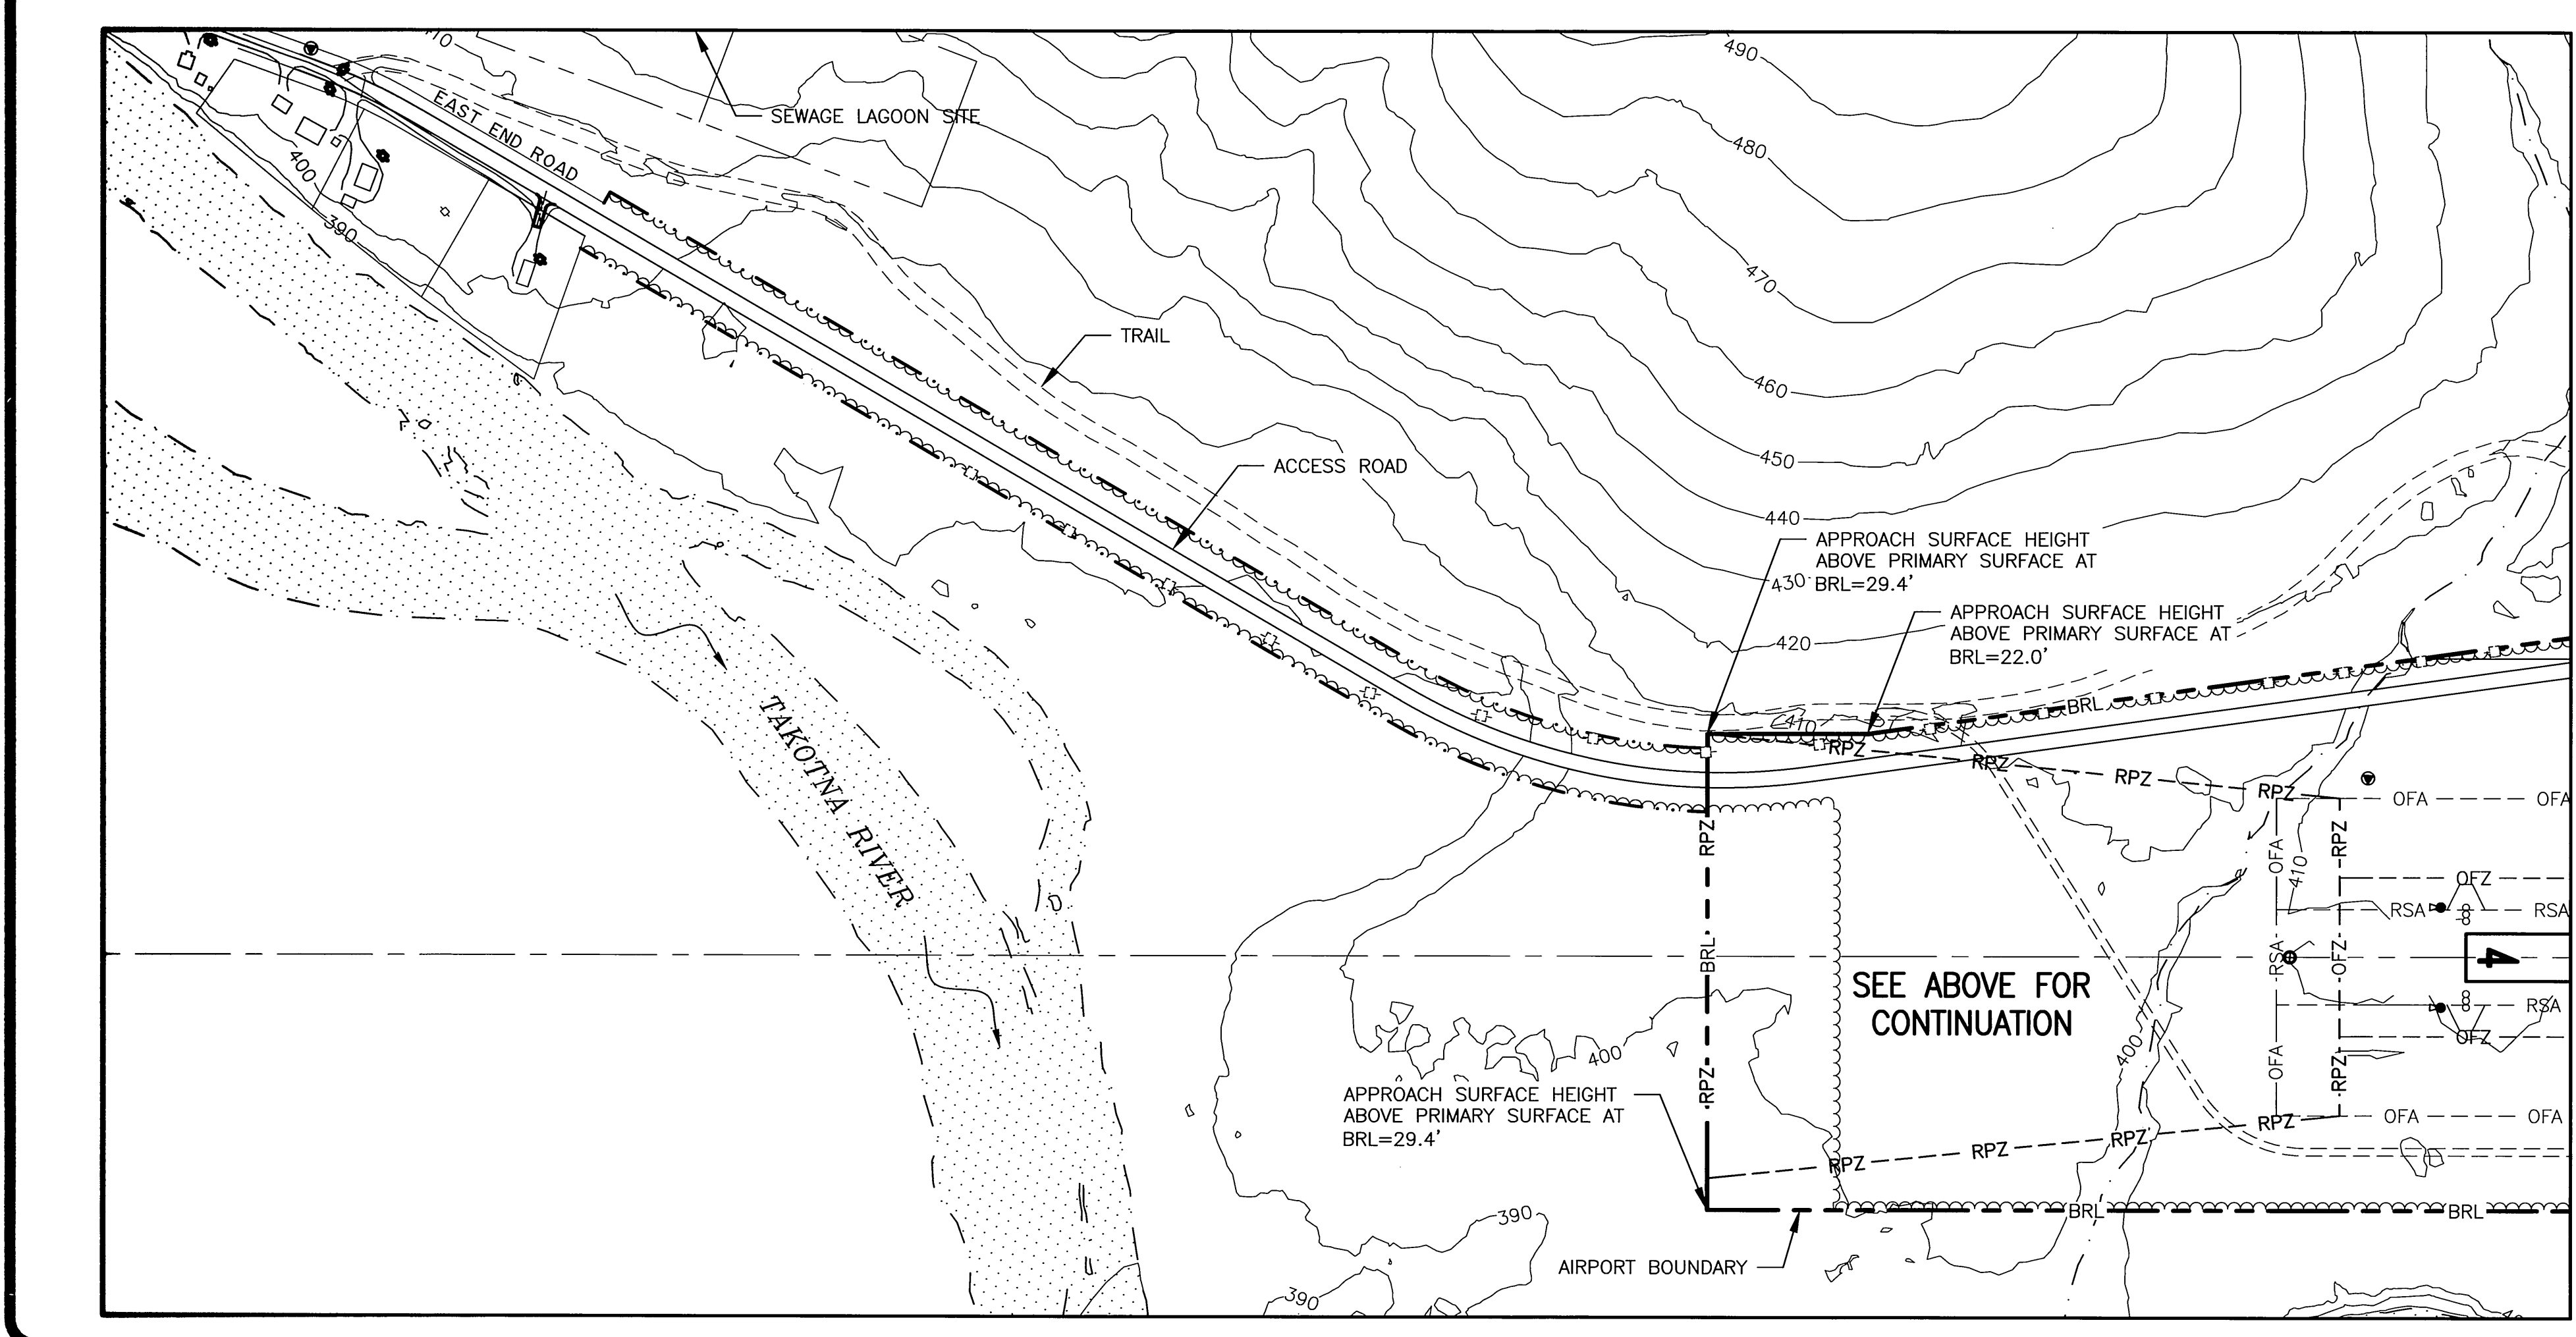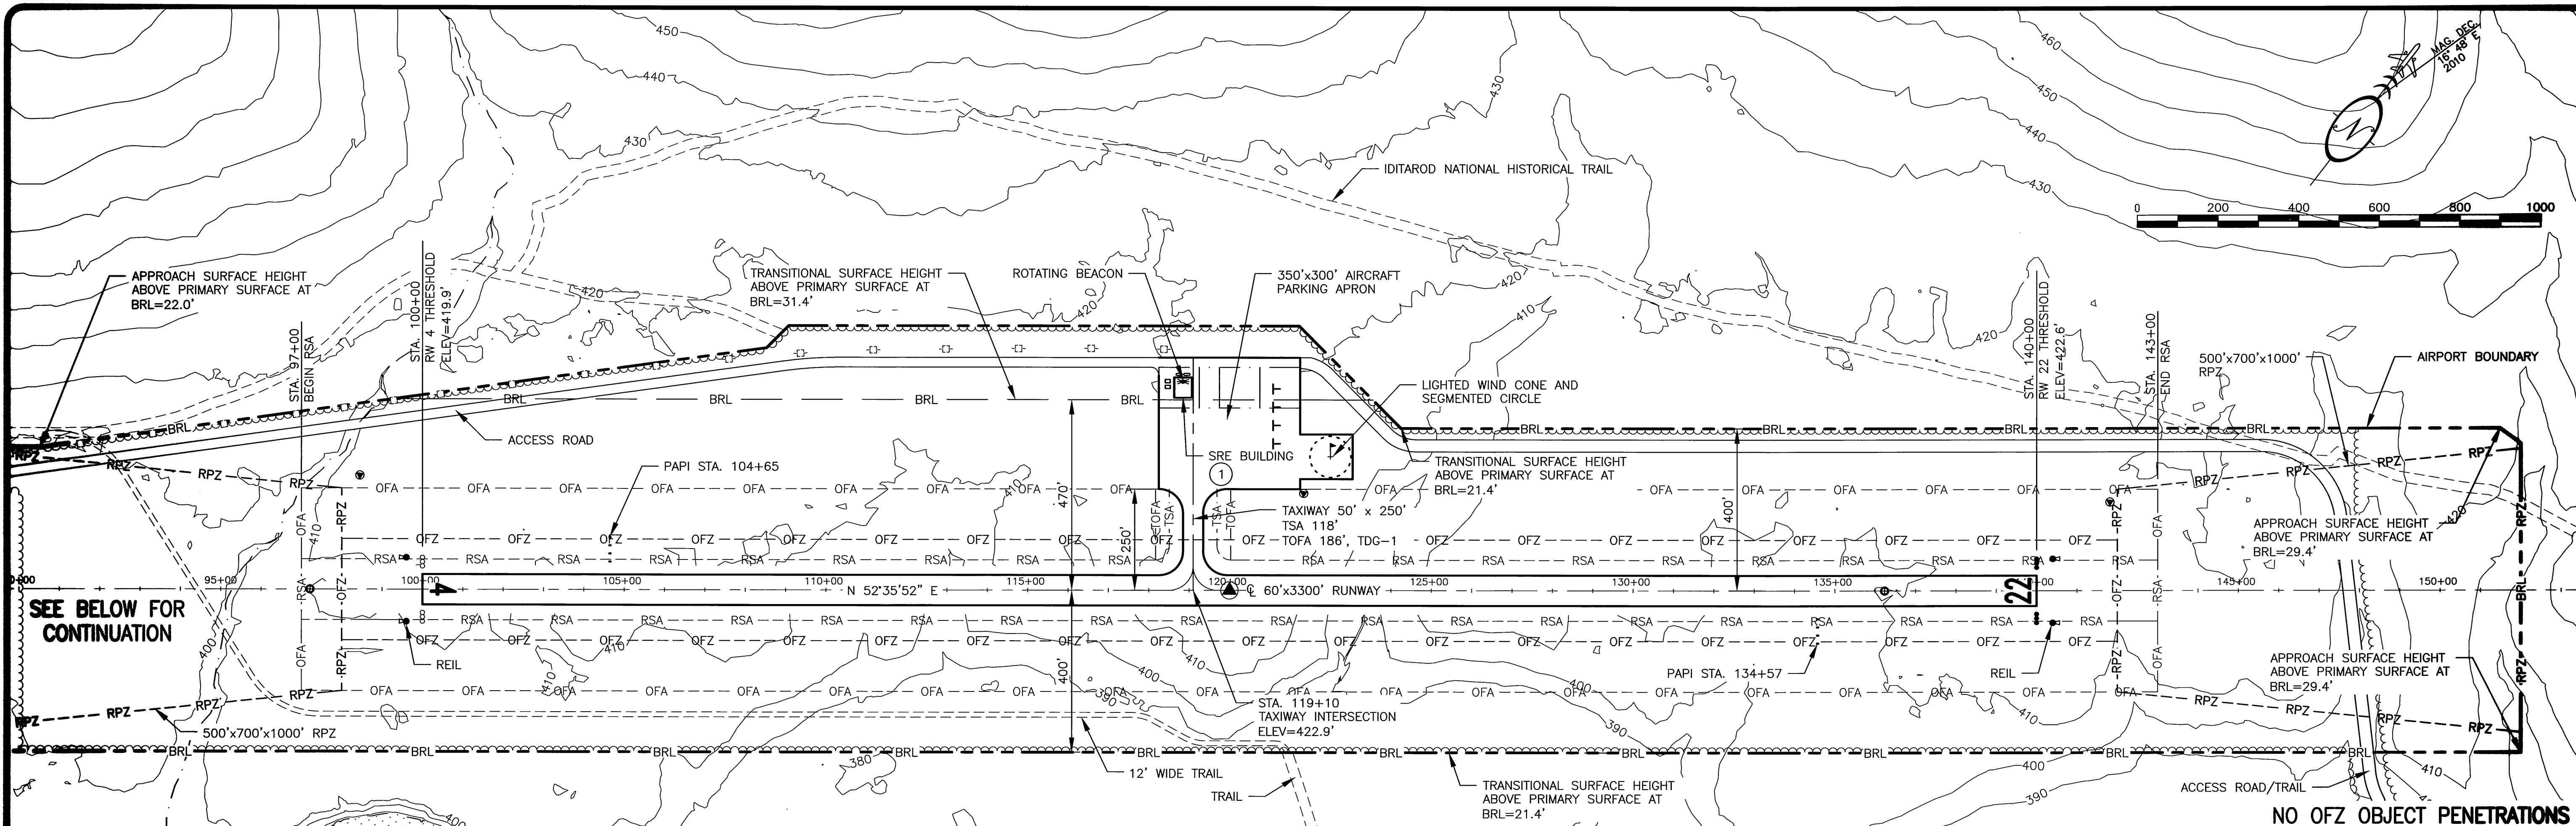

I.D. #	DESCRIPTION	STATION	OFFSET	TOP ELEVATION	OBSTRUCTION MARKING
1	SRE BUILDING	118+85	475' LT.	453.6	NONE

STATE OF ALASKA DEPARTMENT OF TRANSPORTATION AND PUBLIC FACILITIES CENTRAL REGION		DATE: 4/19/2013 SHEET: 4 OF 10
TAKOTNA AIRPORT TAKOTNA, ALASKA AIRPORT LAYOUT PLAN ULTIMATE LAYOUT		BY: JGL DATE: 10/24/13 REVISION: AS-BUILT PER PROJECT NO 56774

Date Plotted: 3/28/2013 11:17 AM
 Layout Name: ALP05
 File Name: \\NCPFILE2\JGLES\013000\DWGS\013000-TAKOTNA-ALP-AS-BUILT\013000-TAKOTNA-AS-BUILT-013000.dwg
 Designed By: JGL (USAHA, INC.)
 Checked By: ZMS
 Drawn By: MRM

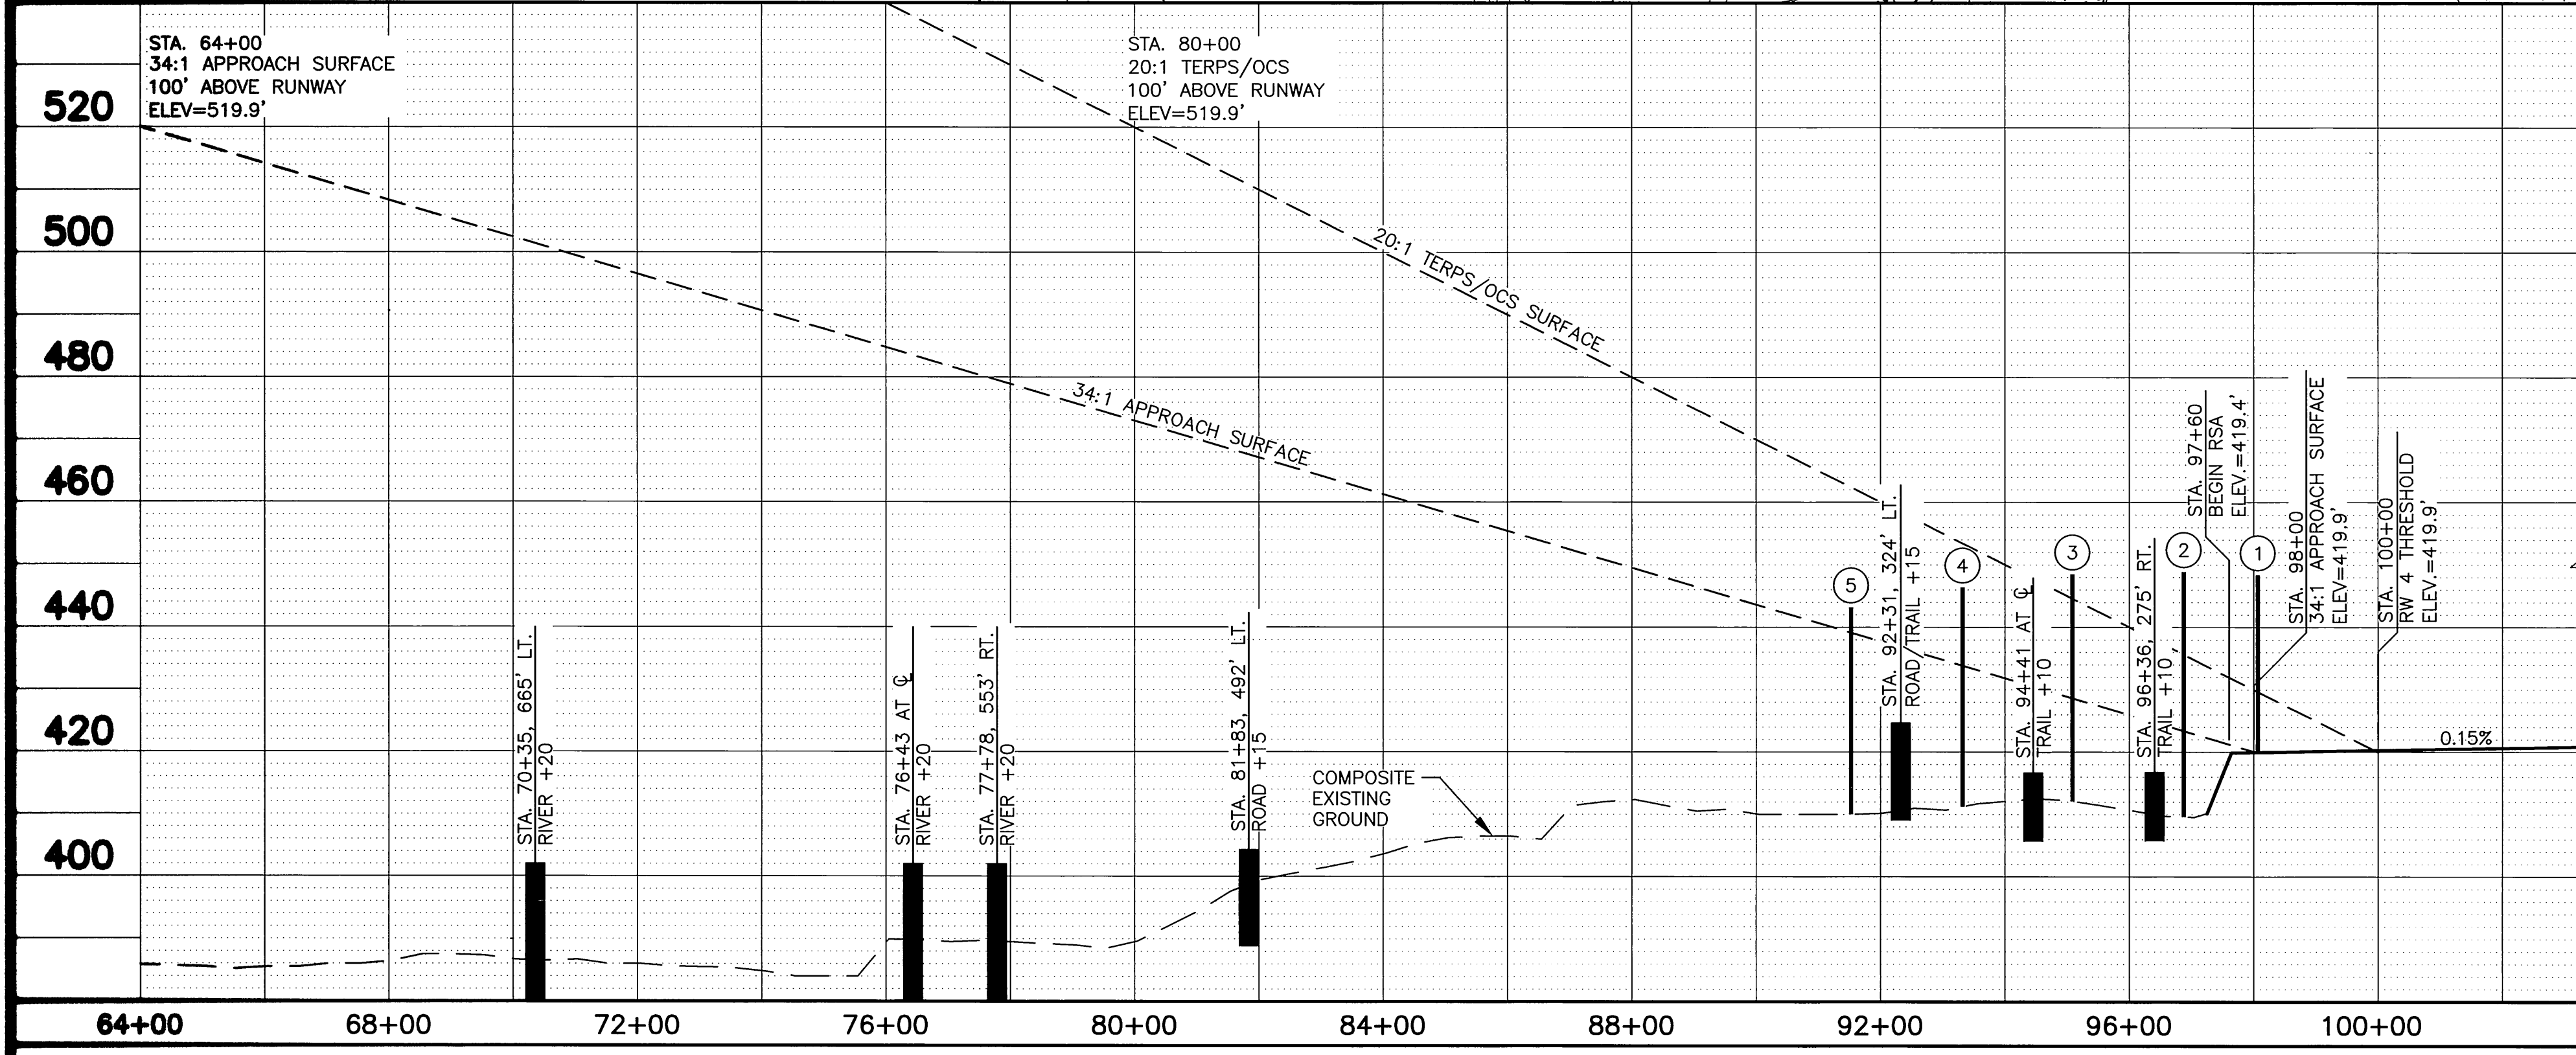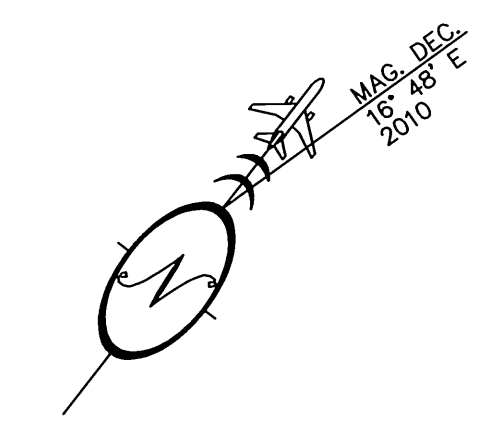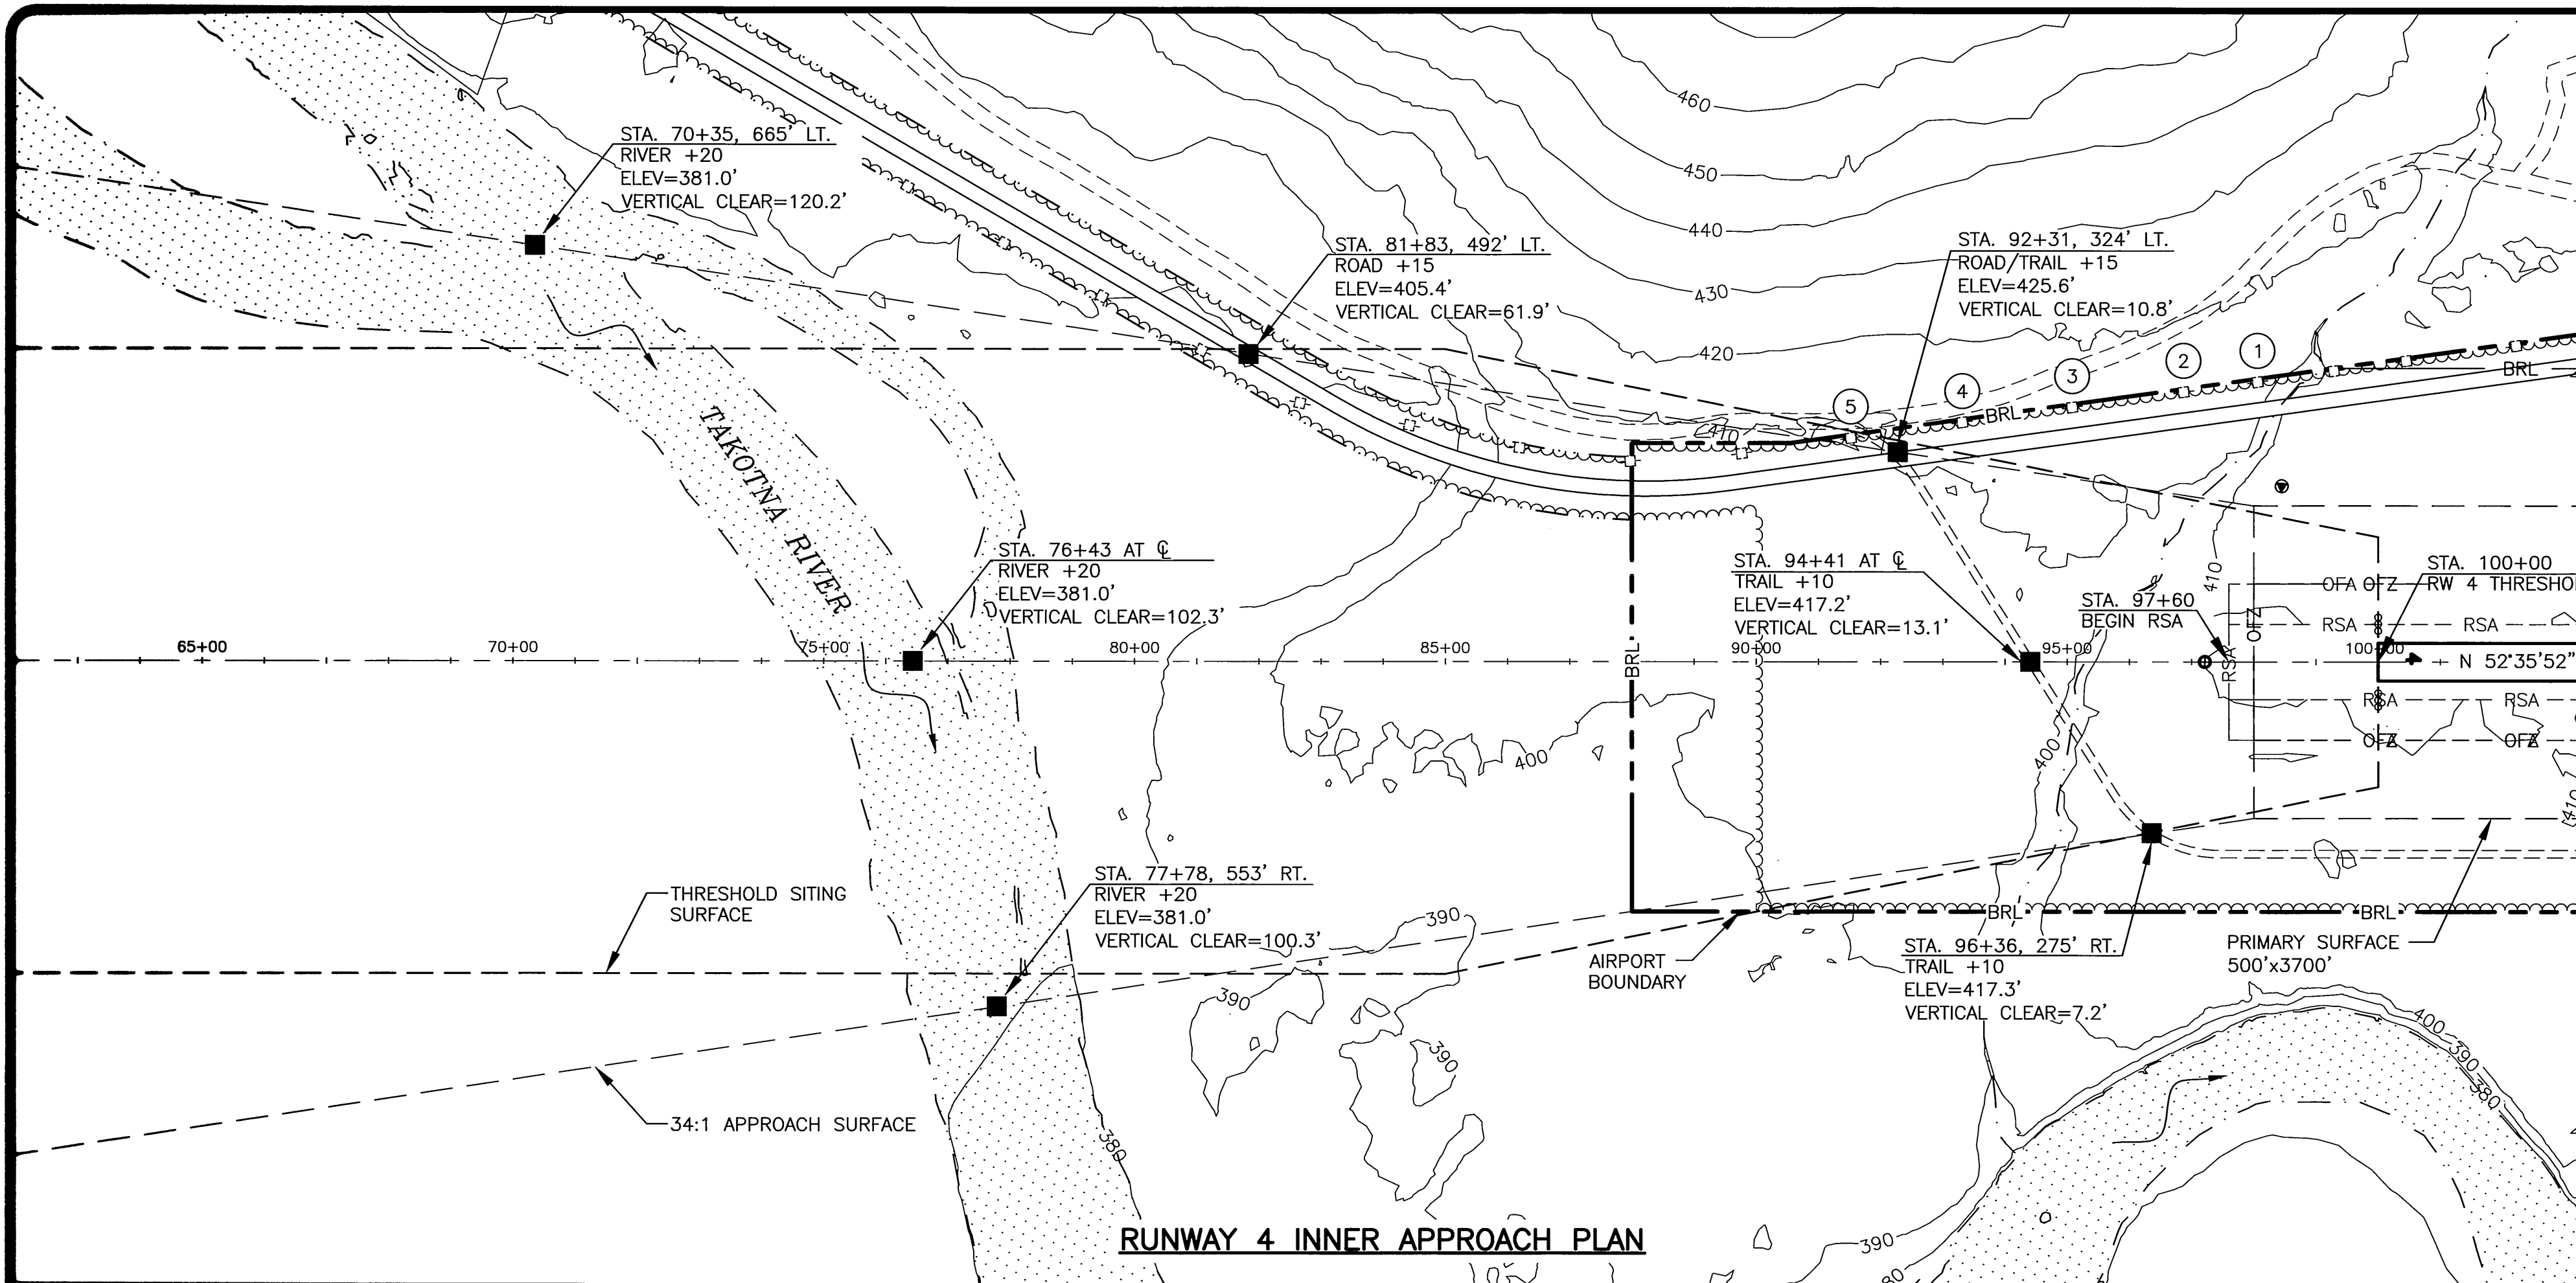

ID #	DESCRIPTION	STATION/OFFSET	ELEVATION	SURFACE PENETRATED	SURFACE ELEVATION	AMOUNT PENETRATION	DISPOSITION	STAGE TO CORRECT
1	POWER POLE	98+06.4, 448.2 LT	448.4	TRANSITIONAL	448.2	0.2	TO REMAIN	NONE
2	POWER POLE	96+87.22, 432.0 LT	448.9	TRANSITIONAL	446.8	2.1	TO REMAIN	NONE
3	POWER POLE	95+08.22, 407.6 LT	448.5	TRANSITIONAL	444.8	3.7	TO REMAIN	NONE
4	POWER POLE	93+31.39, 383.5 LT	446.4	TRANSITIONAL	442.7	3.7	TO REMAIN	NONE
5	POWER POLE	91+52.17, 358.3 LT	443.1	TRANSITIONAL	440.6	2.5	TO REMAIN	NONE

NOTE: REFER TO THE AIRPORT AIRSPACE DRAWING FOR PENETRATIONS OF THE OUTER APPROACH SURFACES

NOTES:

- THRESHOLD SITING CRITERIA BASED ON APPROACH END OF RUNWAYS EXPECTED TO SERVE LARGE AIRPLANES (VISUAL DAY/NIGHT); OR INSTRUMENT MINIMUMS GREATER THAN 1 STATUTE MILE (DAY ONLY), PER TABLE 3-2 AC 150/5300-13A.
- NO THRESHOLD SITING SURFACE OBJECT PENETRATIONS.
- OBSTRUCTION CLEARING SLOPE EXTENDS OUT 20:1 FOR 8,500 FT.





STATE OF ALASKA
DEPARTMENT OF TRANSPORTATION
AND PUBLIC FACILITIES
CENTRAL REGION


TAKOTNA AIRPORT
 TAKOTNA, ALASKA
 AIRPORT LAYOUT PLAN
 EXISTING INNER PORTION OF
 RW 4 APPROACH SURFACE

DATE:
 4/19/2013
 SHEET:
5
 OF
10


BY	DATE	REVISION
JGL	10/24/13	AS-BUILT PER PROJECT NO 56774

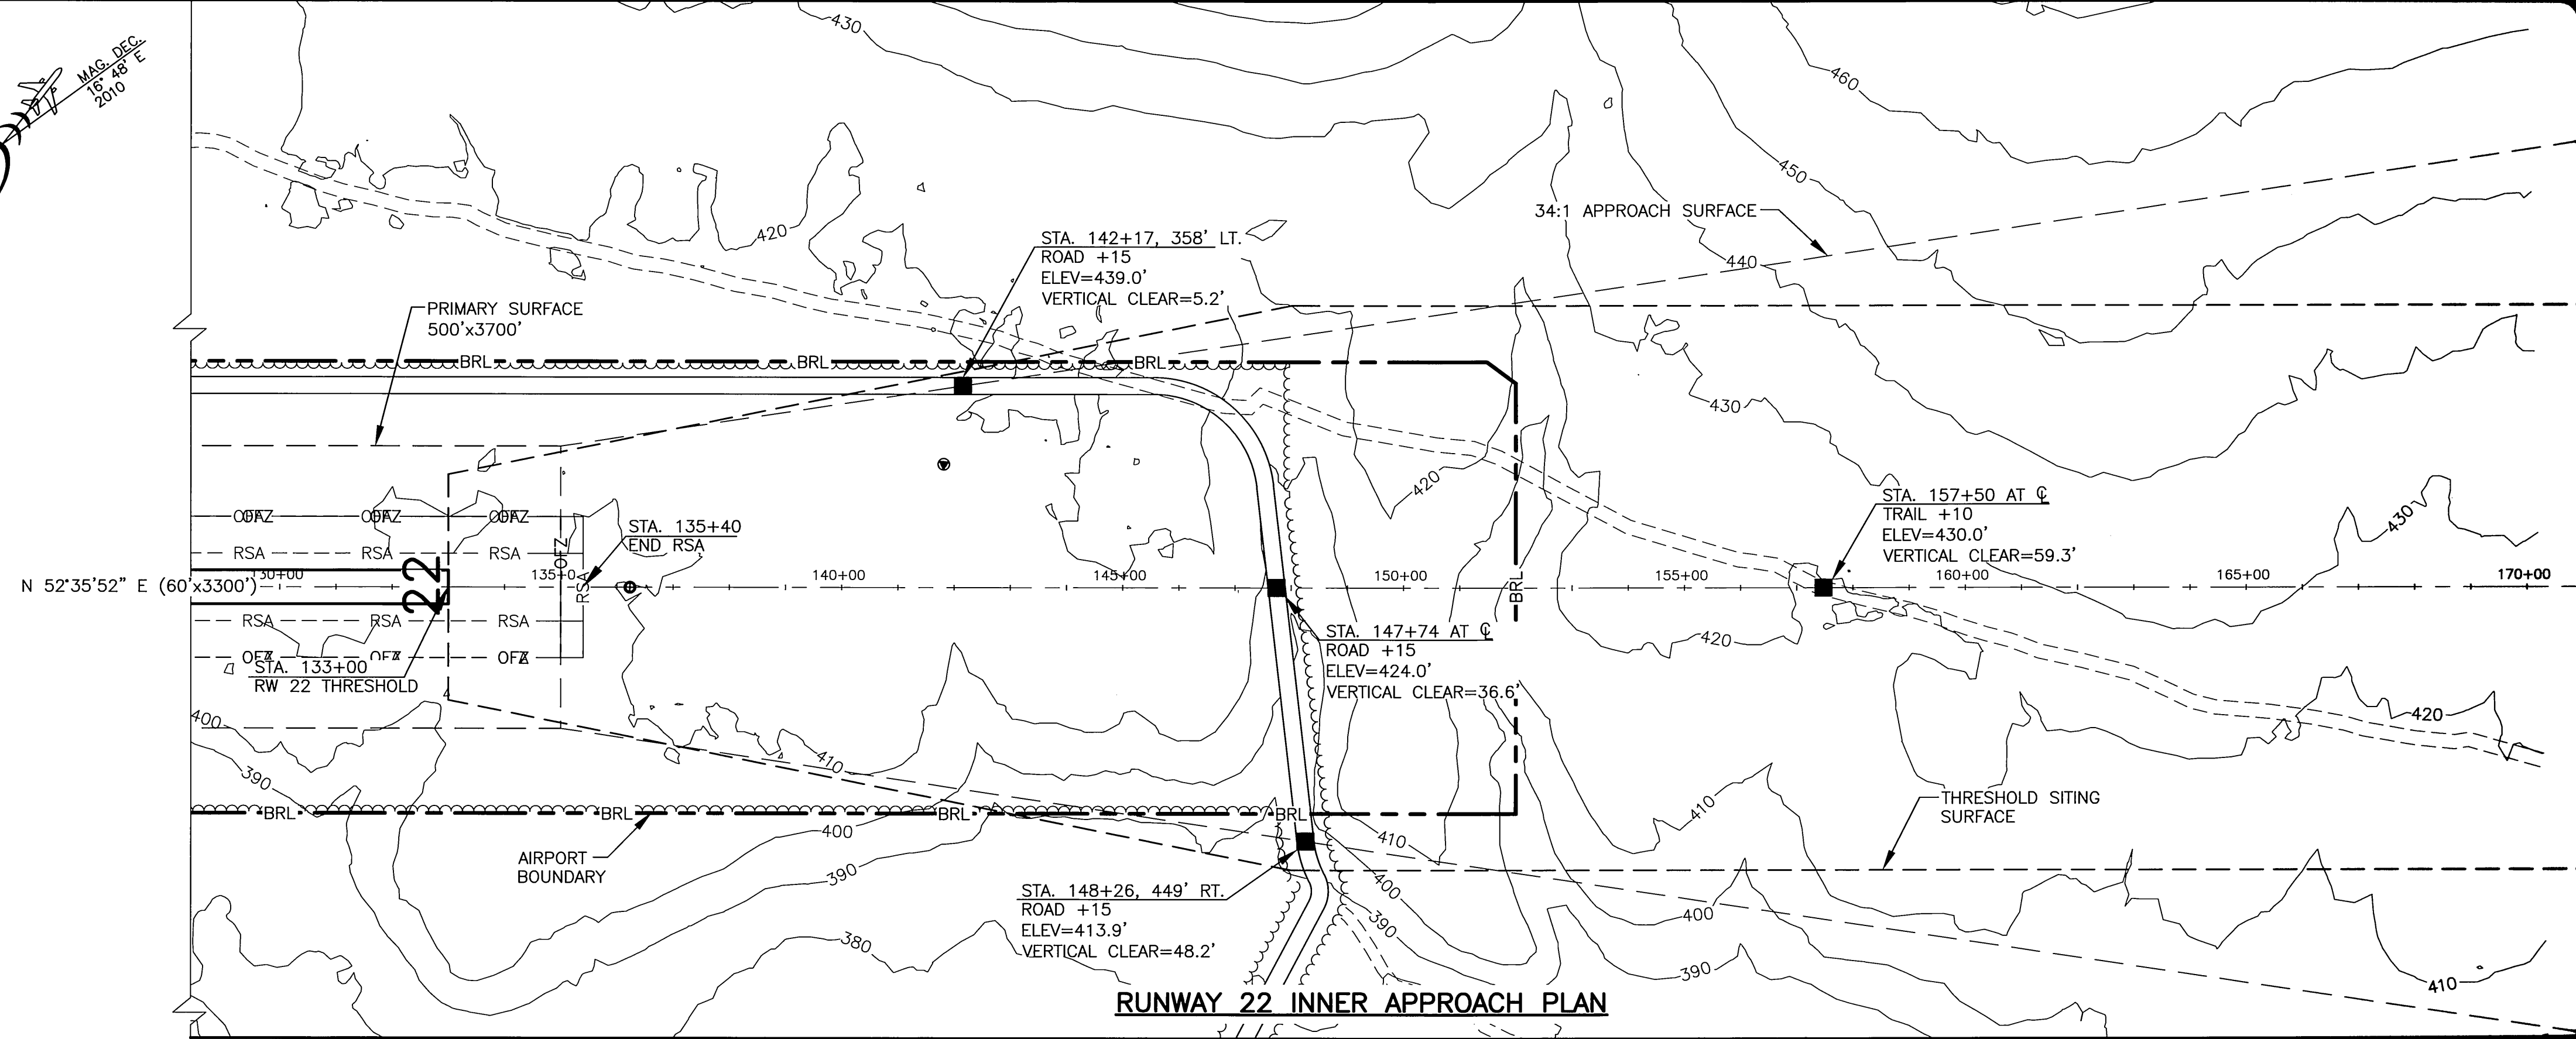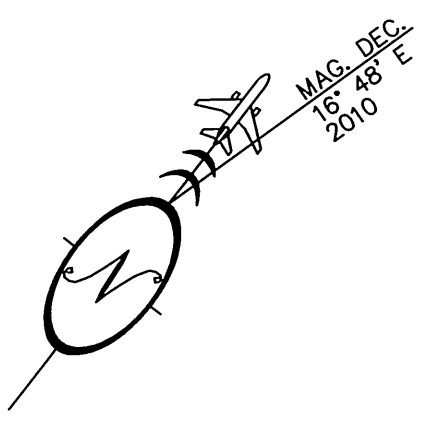

RUNWAY 22 INNER APPROACH PLAN

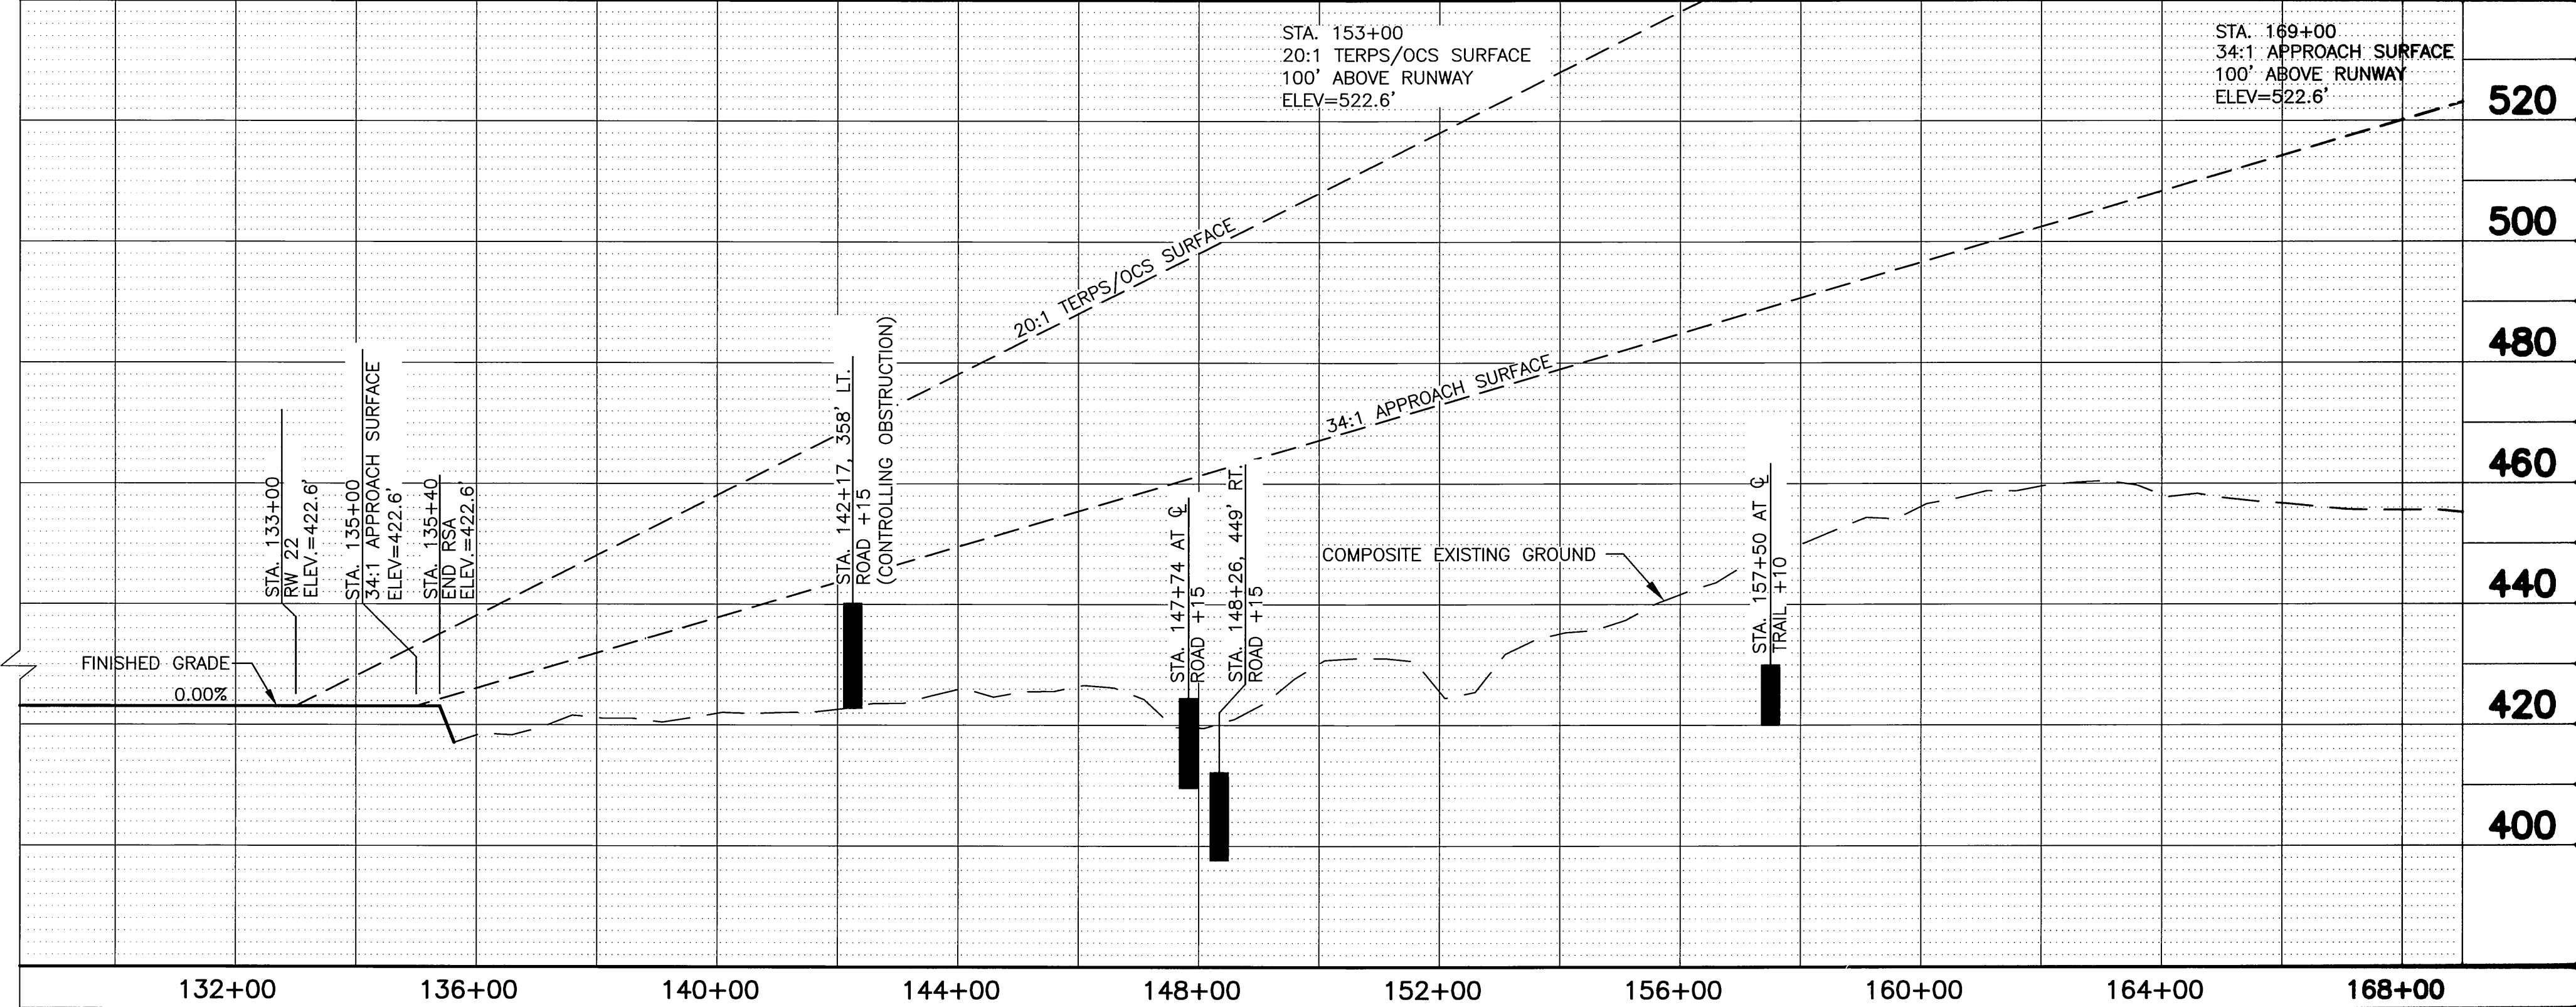

RUNWAY 22 INNER APPROACH PROFILE

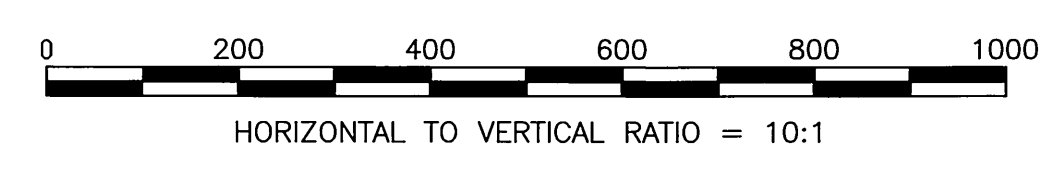

PART 77 SURFACE OBSTRUCTIONS TABLE (INNER PORTION RW 22)								
ID #	DESCRIPTION	STATION/OFFSET	ELEVATION	SURFACE PENETRATED	SURFACE ELEVATION	AMOUNT PENETRATION	DISPOSITION	STAGE TO CORRECT
NONE								

NOTE: REFER TO THE AIRPORT AIRSPACE DRAWING FOR PENETRATIONS OF THE OUTER APPROACH SURFACES

NOTES:

1. THE CONTROLLING OBSTRUCTION FOR RUNWAY 22 IS THE ROAD CROSSING AT STA. 142+17, 358' LT. ELEVATION INCLUDING 15' VEHICLE IS 439.0'. THE OBSTRUCTION CLEARANCE SLOPE IS ESTABLISHED AS 45:1 PER FAA AC 150/5200-35, SECTION 4, DATA ELEMENT NUMBER 57.
2. THRESHOLD SITING CRITERIA BASED ON APPROACH END OF RUNWAYS EXPECTED TO SERVE LARGE AIRPLANES (VISUAL DAY/NIGHT); OR INSTRUMENT MINIMUMS GREATER THAN 1 STATUTE MILE (DAY ONLY), PER TABLE 3-2 AC 150/5300-13A.
3. NO THRESHOLD SITING SURFACE OBJECT PENETRATIONS.
4. OBSTRUCTION CLEARING SLOPE EXTENDS OUT 20:1 FOR 8,500 FT.

Date Plotted: 3/29/2013 11:17 AM
 Layout Name: ALP06
 File Name: \\VAPC\FLEET\JOBS\13500\DWGS\C\13500-TAKOTNA-ALP-AS-BUILT\13500-TAKOTNA-AS-BUILT-06.dwg, 8/13/2000
 Designed By: JGL (USKH, INC.)
 Checked By: ZMS
 Drawn By: MRL




BY	DATE	REVISION
JGL	10/24/13	AS-BUILT PER PROJECT NO 56774

**STATE OF ALASKA
DEPARTMENT OF TRANSPORTATION
AND PUBLIC FACILITIES
CENTRAL REGION**

TAKOTNA AIRPORT
TAKOTNA, ALASKA
AIRPORT LAYOUT PLAN
EXISTING INNER PORTION OF
RW 22 APPROACH SURFACE

DATE:
4/19/2013
SHEET:
6
OF
10

Date Plotted: 3/28/2013 11:17 AM
 Layout Name: A17
 The Name: \\MAPLEZ\JOBS\013000\DWG\C\013000-TAKOTNA-AP-RESULTS\013000-TAKOTNA-AP-RESULTS.dwg
 Designed By: JGL (USAR, INC.)
 Checked By: ZMS
 Drawn By: MRM

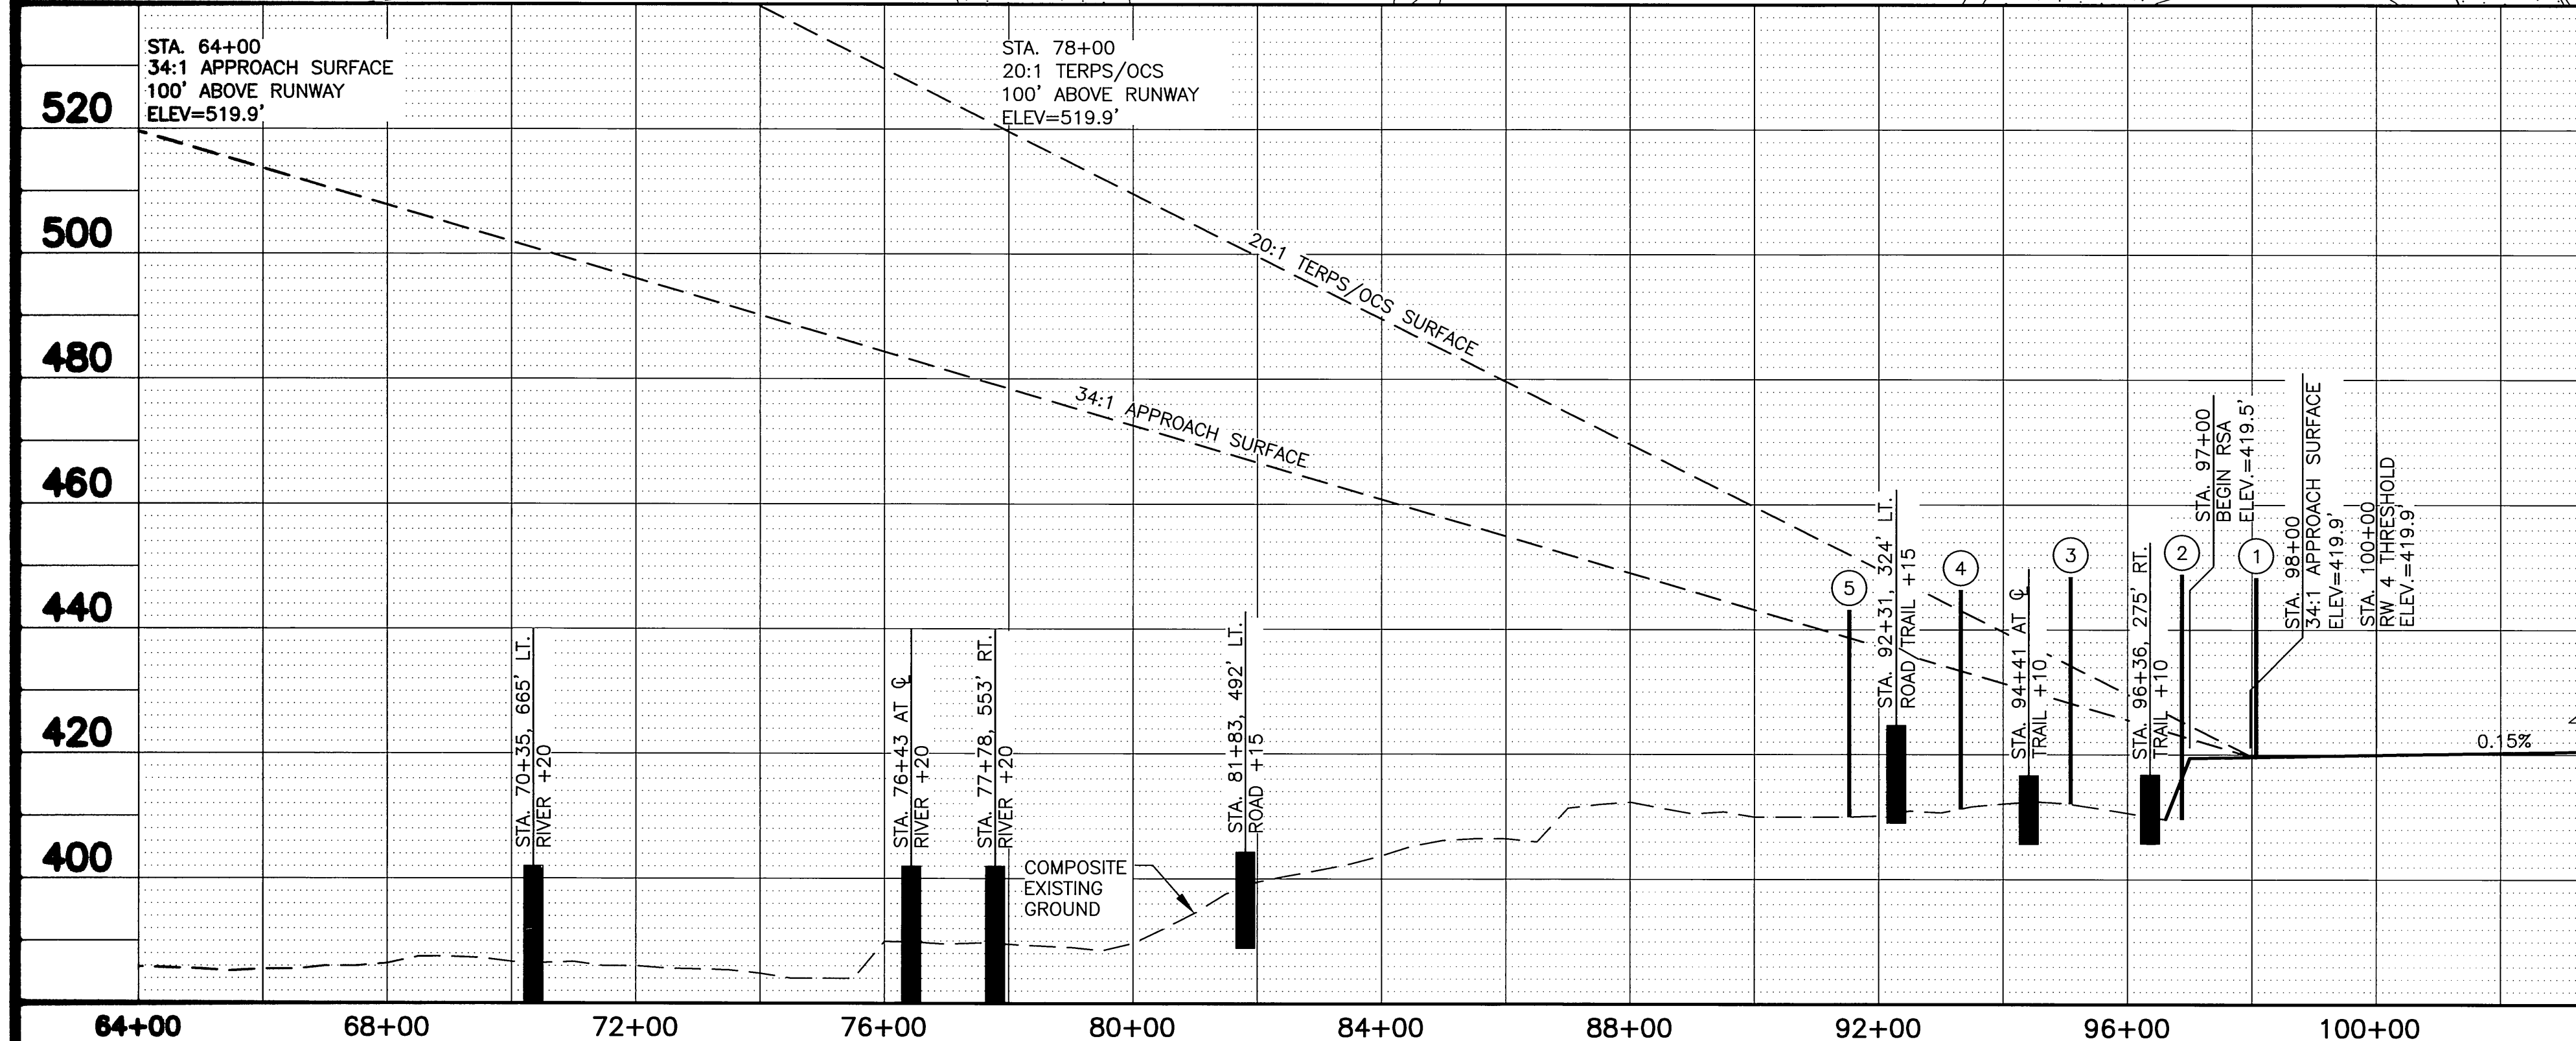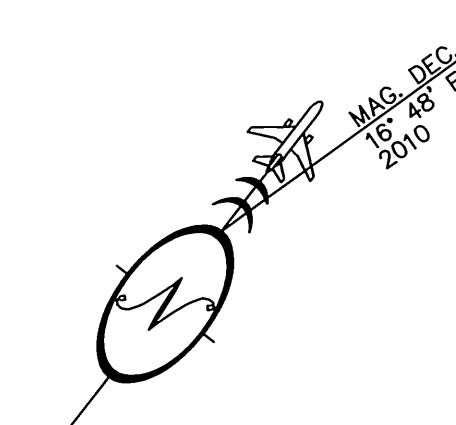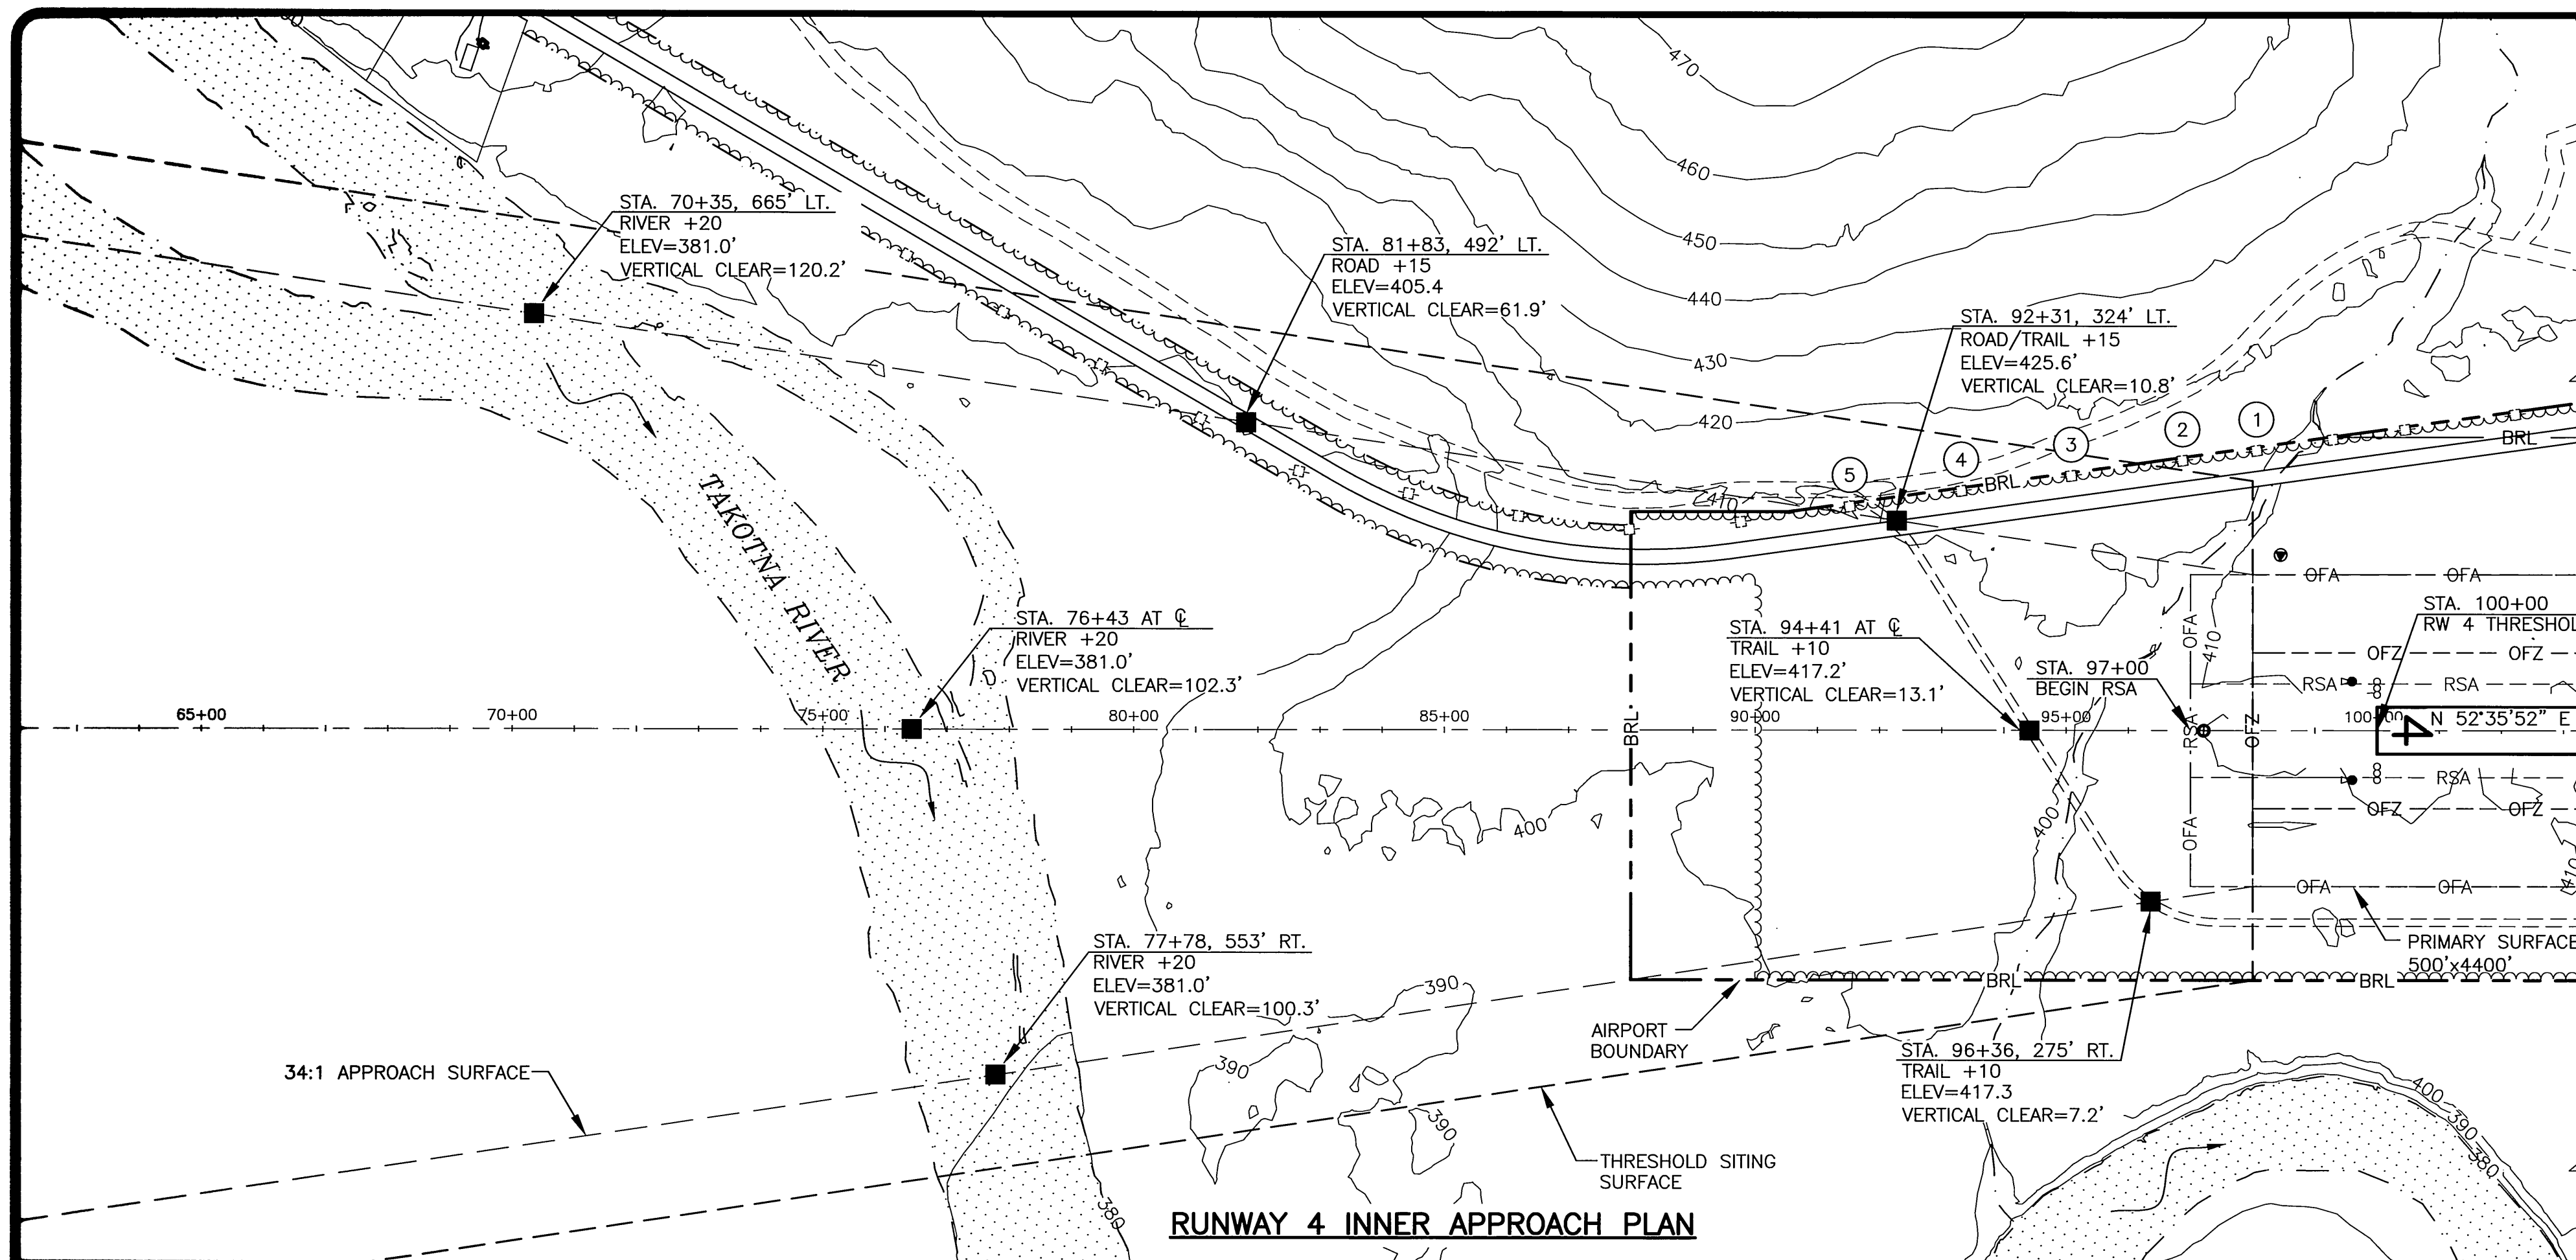

RUNWAY 4 INNER APPROACH PROFILE
 0 200 400 600 800 1000
 HORIZONTAL TO VERTICAL RATIO = 10:1

PART 77 SURFACE OBSTRUCTIONS TABLE (INNER PORTION RW 4)

ID #	DESCRIPTION	STATION/OFFSET	ELEVATION	SURFACE PENETRATED	SURFACE ELEVATION	AMOUNT PENETRATION	DISPOSITION	STAGE TO CORRECT
1	POWER POLE	98+06.4, 448.2 LT	448.4	TRANSITIONAL	448.2	0.2	TO REMAIN	NONE
2	POWER POLE	96+87.22, 432.0 LT	448.9	TRANSITIONAL	446.8	2.1	TO REMAIN	NONE
3	POWER POLE	95+08.22, 407.6 LT	448.5	TRANSITIONAL	444.8	3.7	TO REMAIN	NONE
4	POWER POLE	93+31.39, 383.5 LT	446.4	TRANSITIONAL	442.7	3.7	TO REMAIN	NONE
5	POWER POLE	91+52.17, 358.3 LT	443.1	TRANSITIONAL	440.6	2.5	TO REMAIN	NONE

NOTE: REFER TO THE AIRPORT AIRSPACE DRAWING FOR PENETRATIONS OF THE OUTER APPROACH SURFACES. #'s 3 AND 4 ARE THRESHOLD SITING SURFACE OBJECT PENETRATIONS.

NOTES:



1. THRESHOLD SITING CRITERIA BASED ON APPROACH END OF RUNWAYS EXPECTED TO SUPPORT INSTRUMENT NIGHT OPERATIONS SERVING GREATER THAN APPROACH CATEGORY B AIRCRAFT, PER TABLE 3-2, AC 150/5300-13A.
2. OBSTRUCTION CLEARING SLOPE EXTENDS OUT 20:1 FOR 10,000 FT.

BY	DATE	REVISION
JGL	10/24/13	AS-BUILT PER PROJECT NO 56774


**STATE OF ALASKA
 DEPARTMENT OF TRANSPORTATION
 AND PUBLIC FACILITIES
 CENTRAL REGION**

TAKOTNA AIRPORT
 TAKOTNA, ALASKA
 AIRPORT LAYOUT PLAN
 ULTIMATE INNER PORTION OF
 RW 4 APPROACH SURFACE


DATE: 4/19/2013
 SHEET: 7 of 10

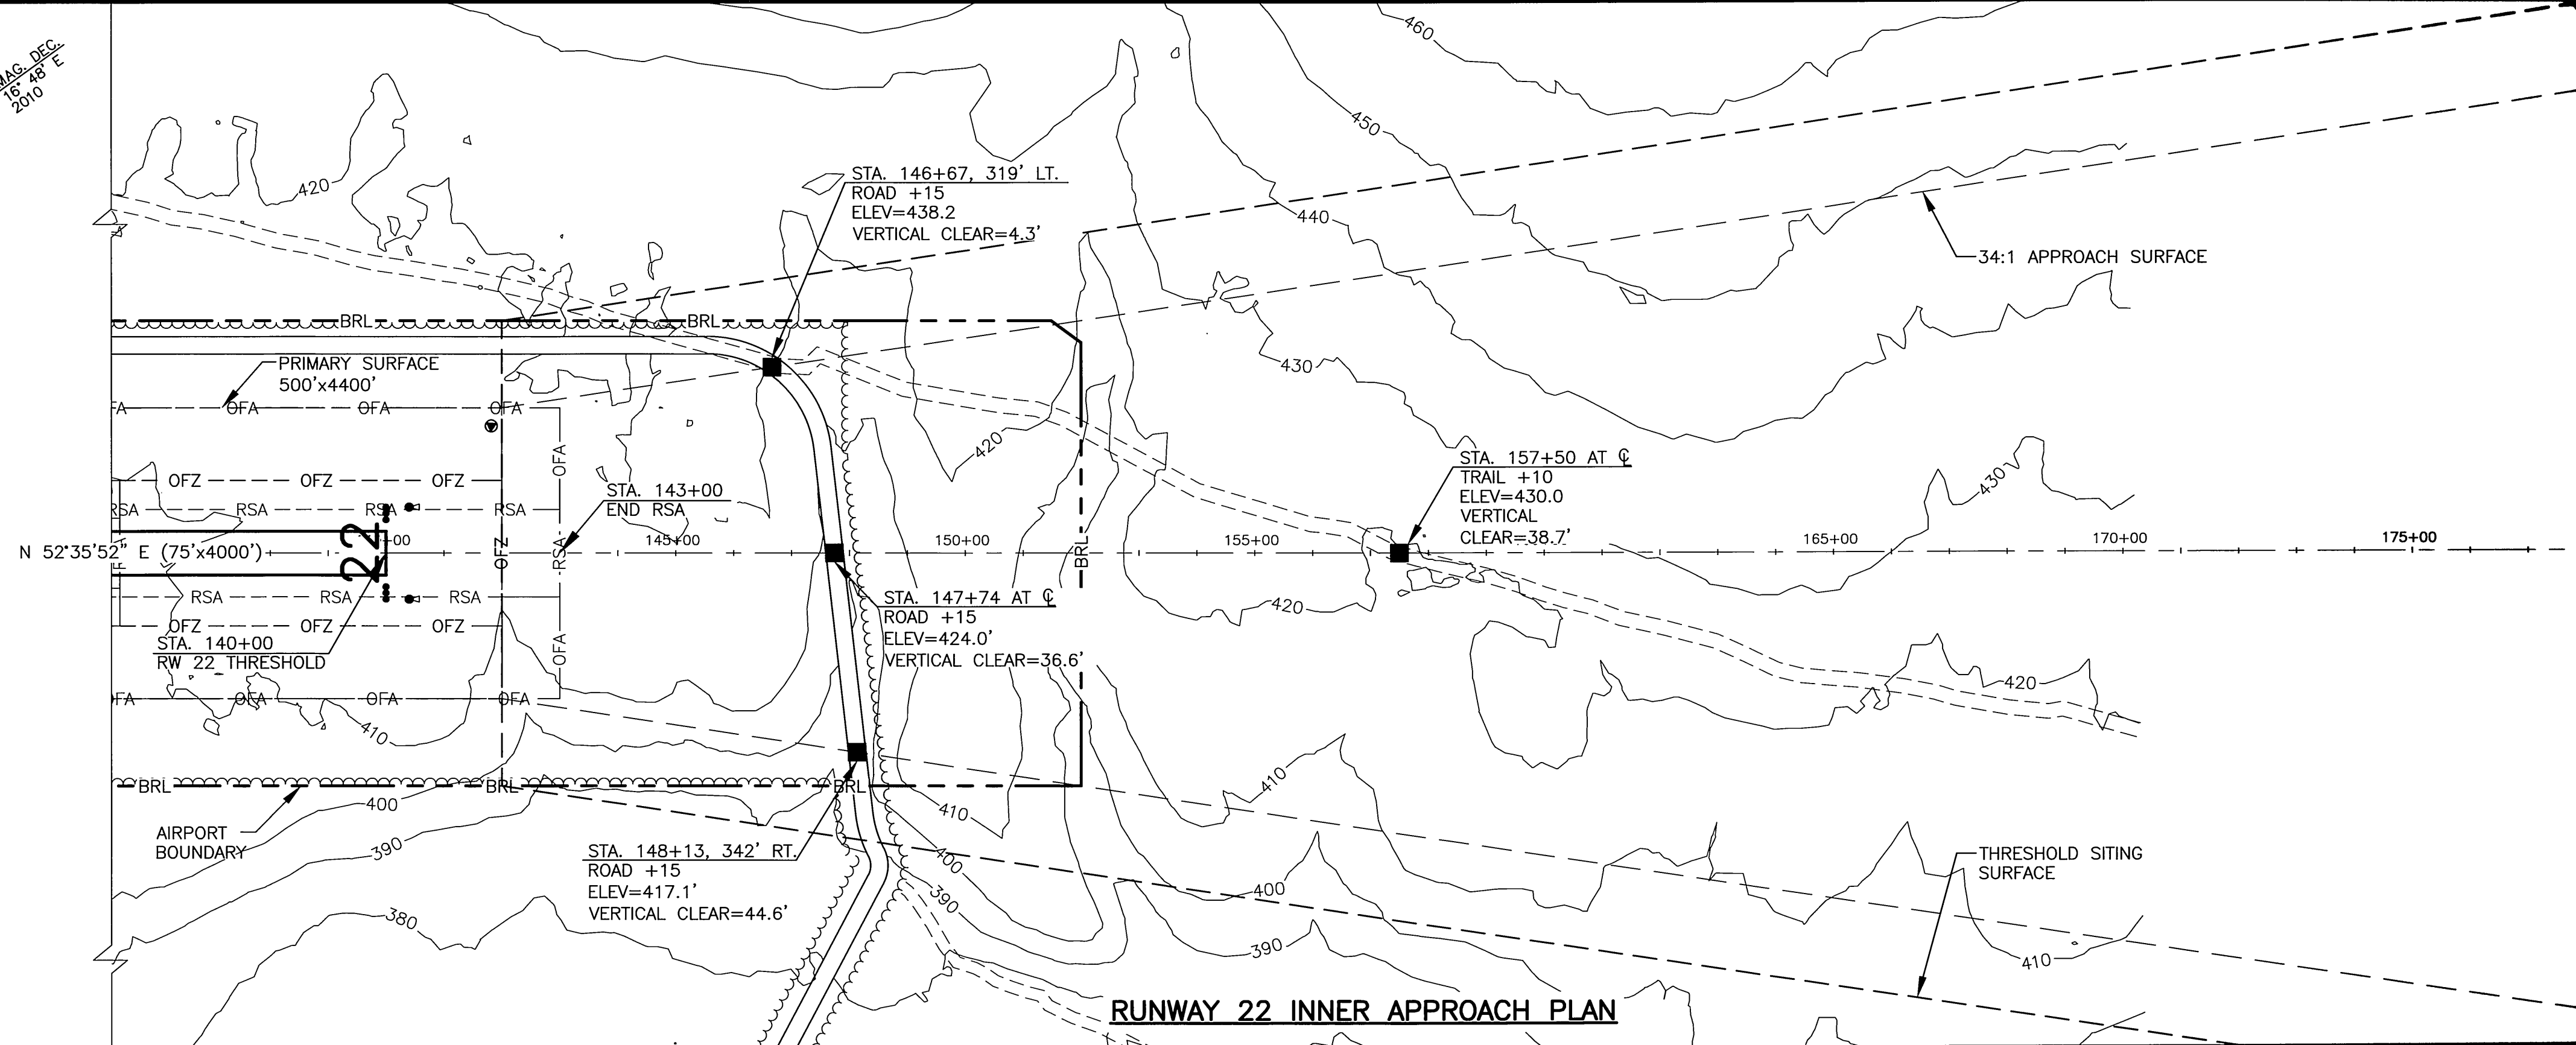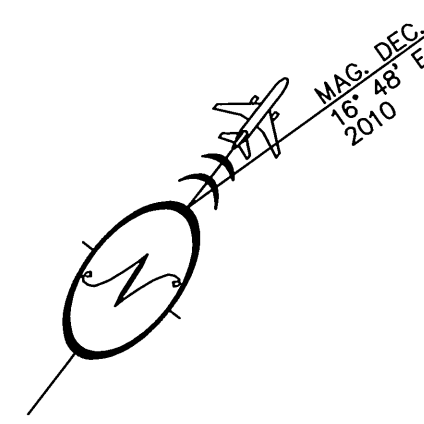

RUNWAY 22 INNER APPROACH PLAN

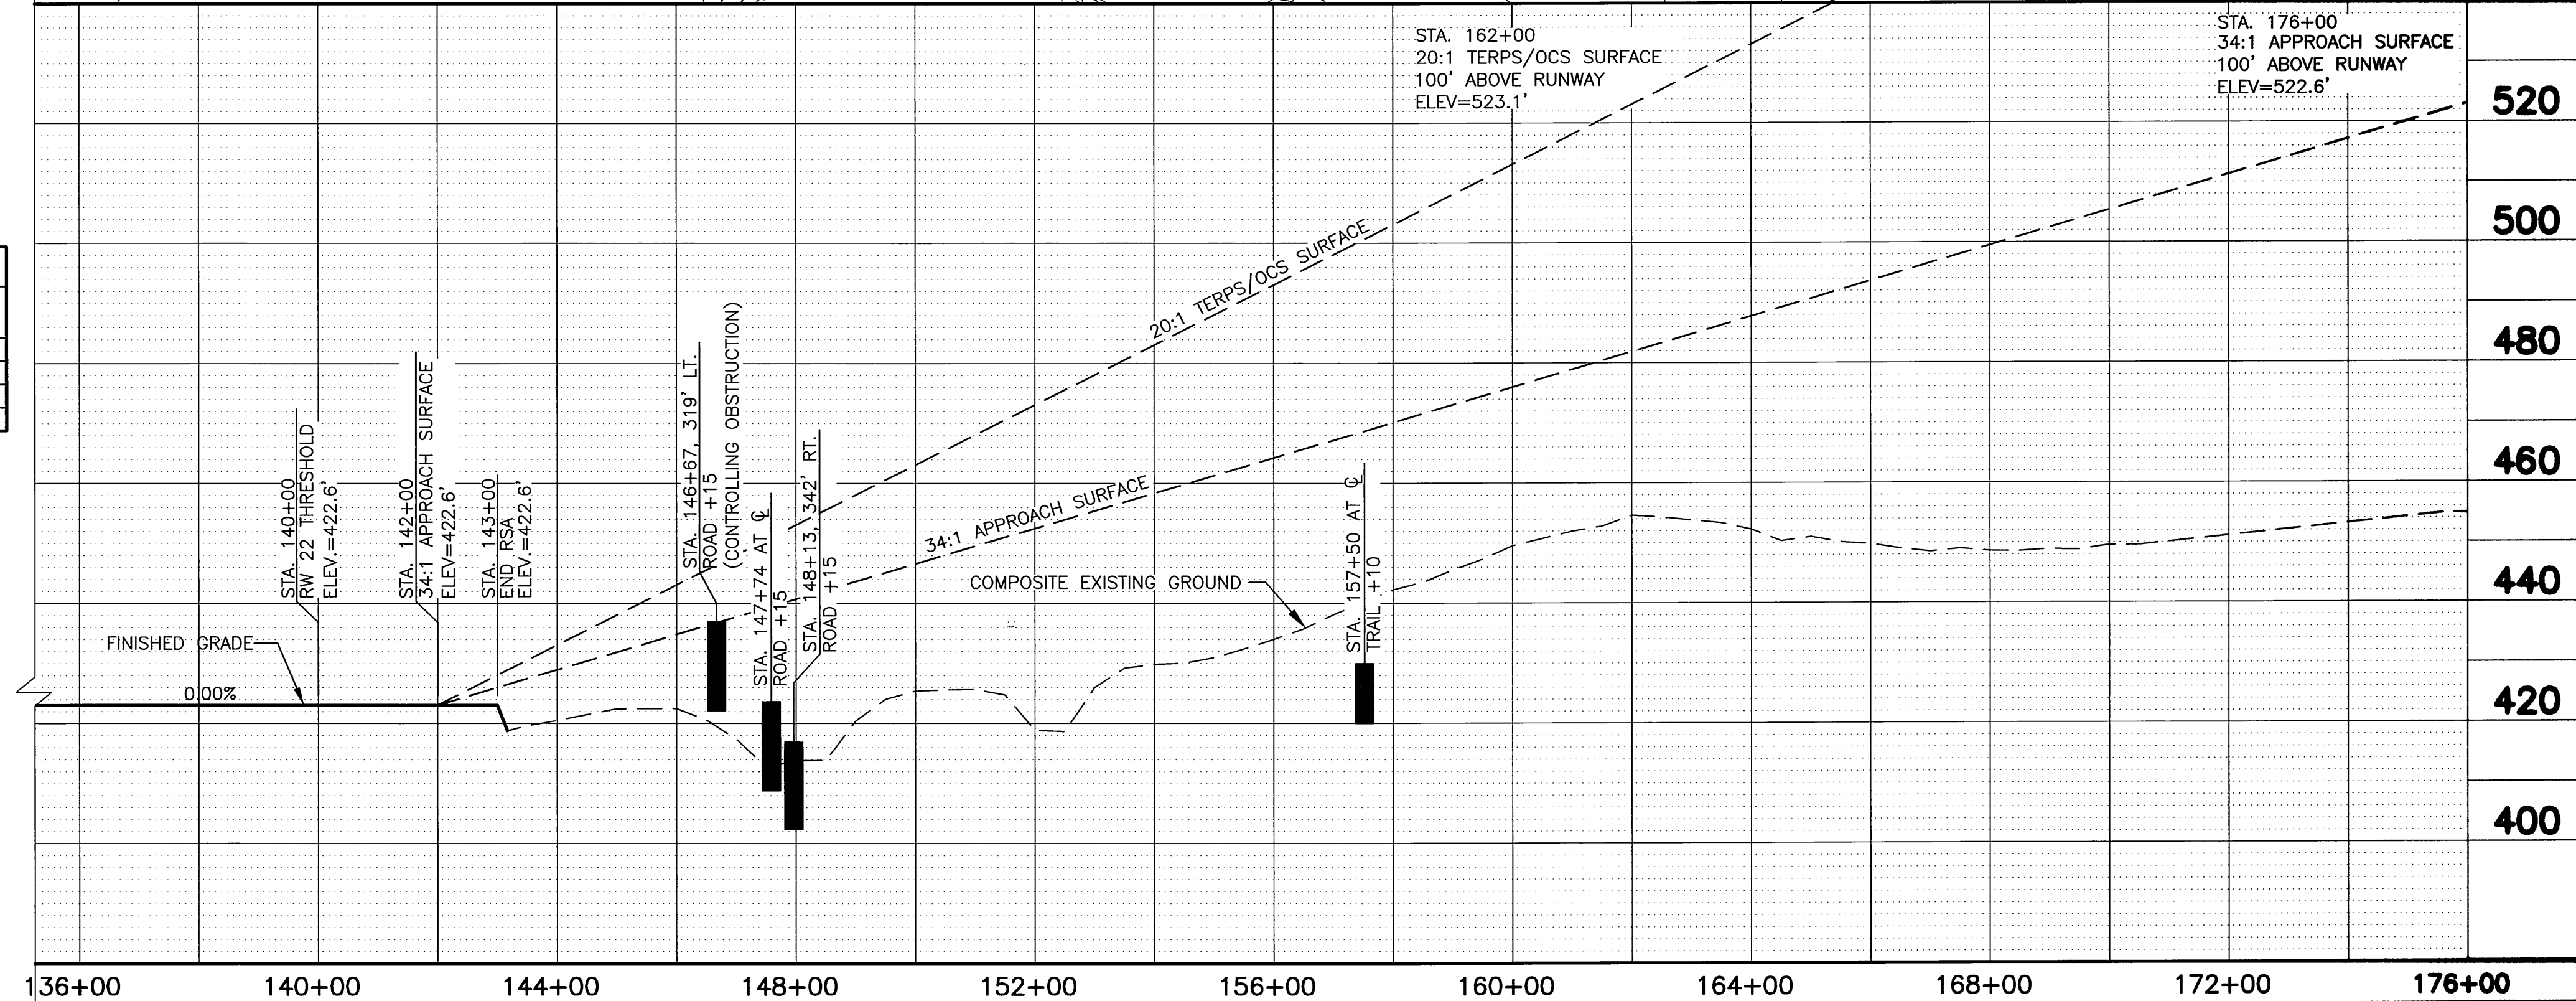

RUNWAY 22 INNER APPROACH PROFILE

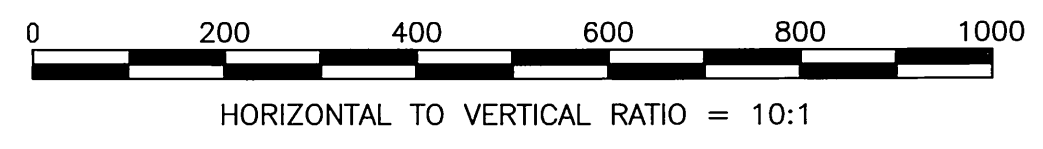

PART 77 SURFACE OBSTRUCTIONS TABLE (INNER PORTION RW 22)								
ID #	DESCRIPTION	STATION/OFFSET	ELEVATION	SURFACE PENETRATED	SURFACE ELEVATION	AMOUNT PENETRATION	DISPOSITION	STAGE TO CORRECT
NONE								

NOTE: REFER TO THE AIRPORT AIRSPACE DRAWING FOR PENETRATIONS OF THE OUTER APPROACH SURFACES

NOTES:

1. THRESHOLD SITING CRITERIA BASED ON APPROACH END OF RUNWAYS EXPECTED TO SUPPORT INSTRUMENT NIGHT OPERATIONS SERVING GREATER THAN APPROACH CATEGORY B AIRCRAFT, PER TABLE 3-2, AC 150/5300-13A.
2. NO THRESHOLD SITING SURFACE OBJECT PENETRATIONS.
3. OBSTRUCTION CLEARING SLOPE EXTENDS OUT 20:1 FOR 10,000 FT.


Date Plotted: 3/28/2013 11:17 AM
 Layout Name: AP108
 File Name: \\VANCE\JOBS\913000\DWG\CA\91300-TAKOTNA-ALP-AS-BUILT\91300-TAKOTNA-ALP-AS-BUILT-01.dwg, 913000

BY	DATE	REVISION
JGL	10/24/13	AS-BUILT PER PROJECT NO 56774




STATE OF ALASKA
DEPARTMENT OF TRANSPORTATION
AND PUBLIC FACILITIES
CENTRAL REGION

TAKOTNA AIRPORT
 TAKOTNA, ALASKA
 AIRPORT LAYOUT PLAN
 ULTIMATE INNER PORTION OF
 RW 22 APPROACH SURFACE

DATE: 4/19/2013
 SHEET: 8 OF 10

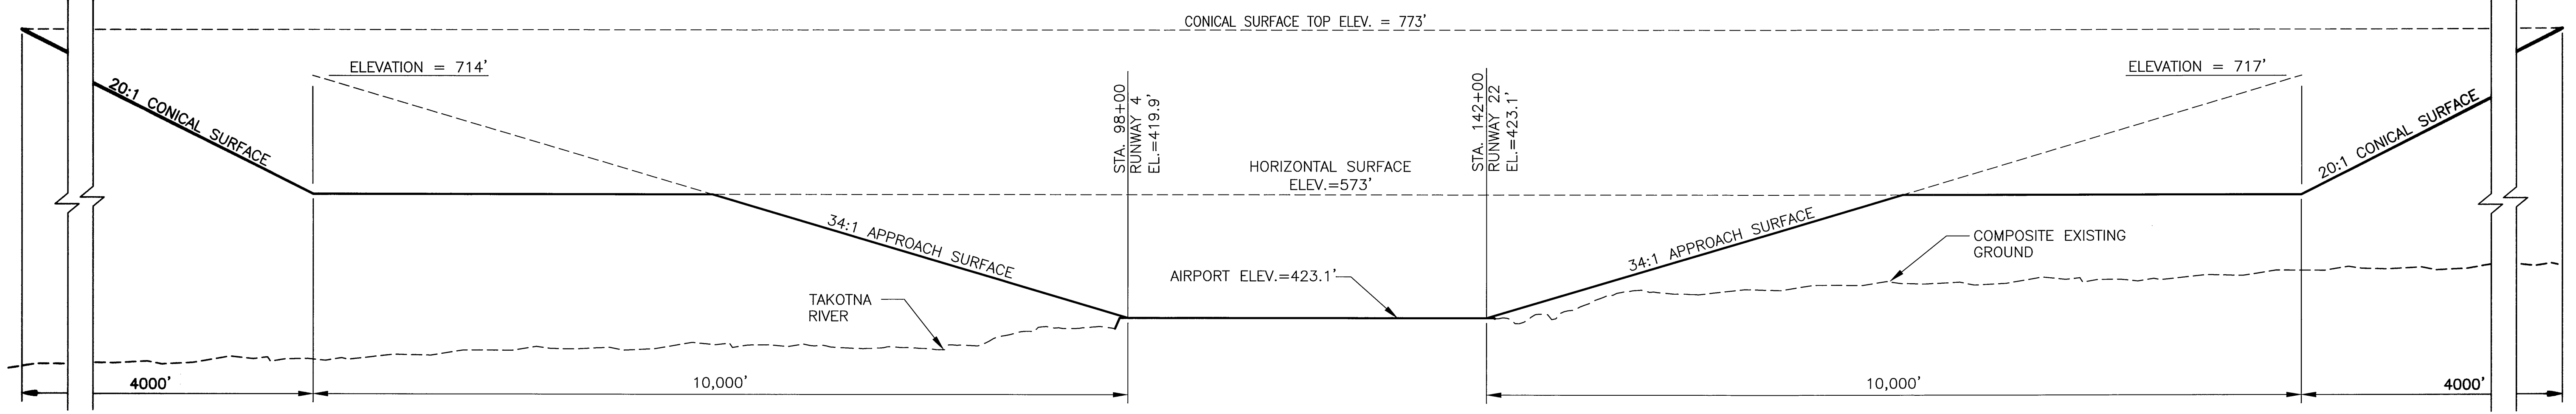

RUNWAY PROFILE

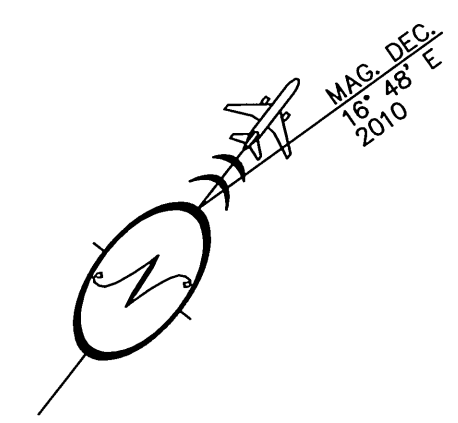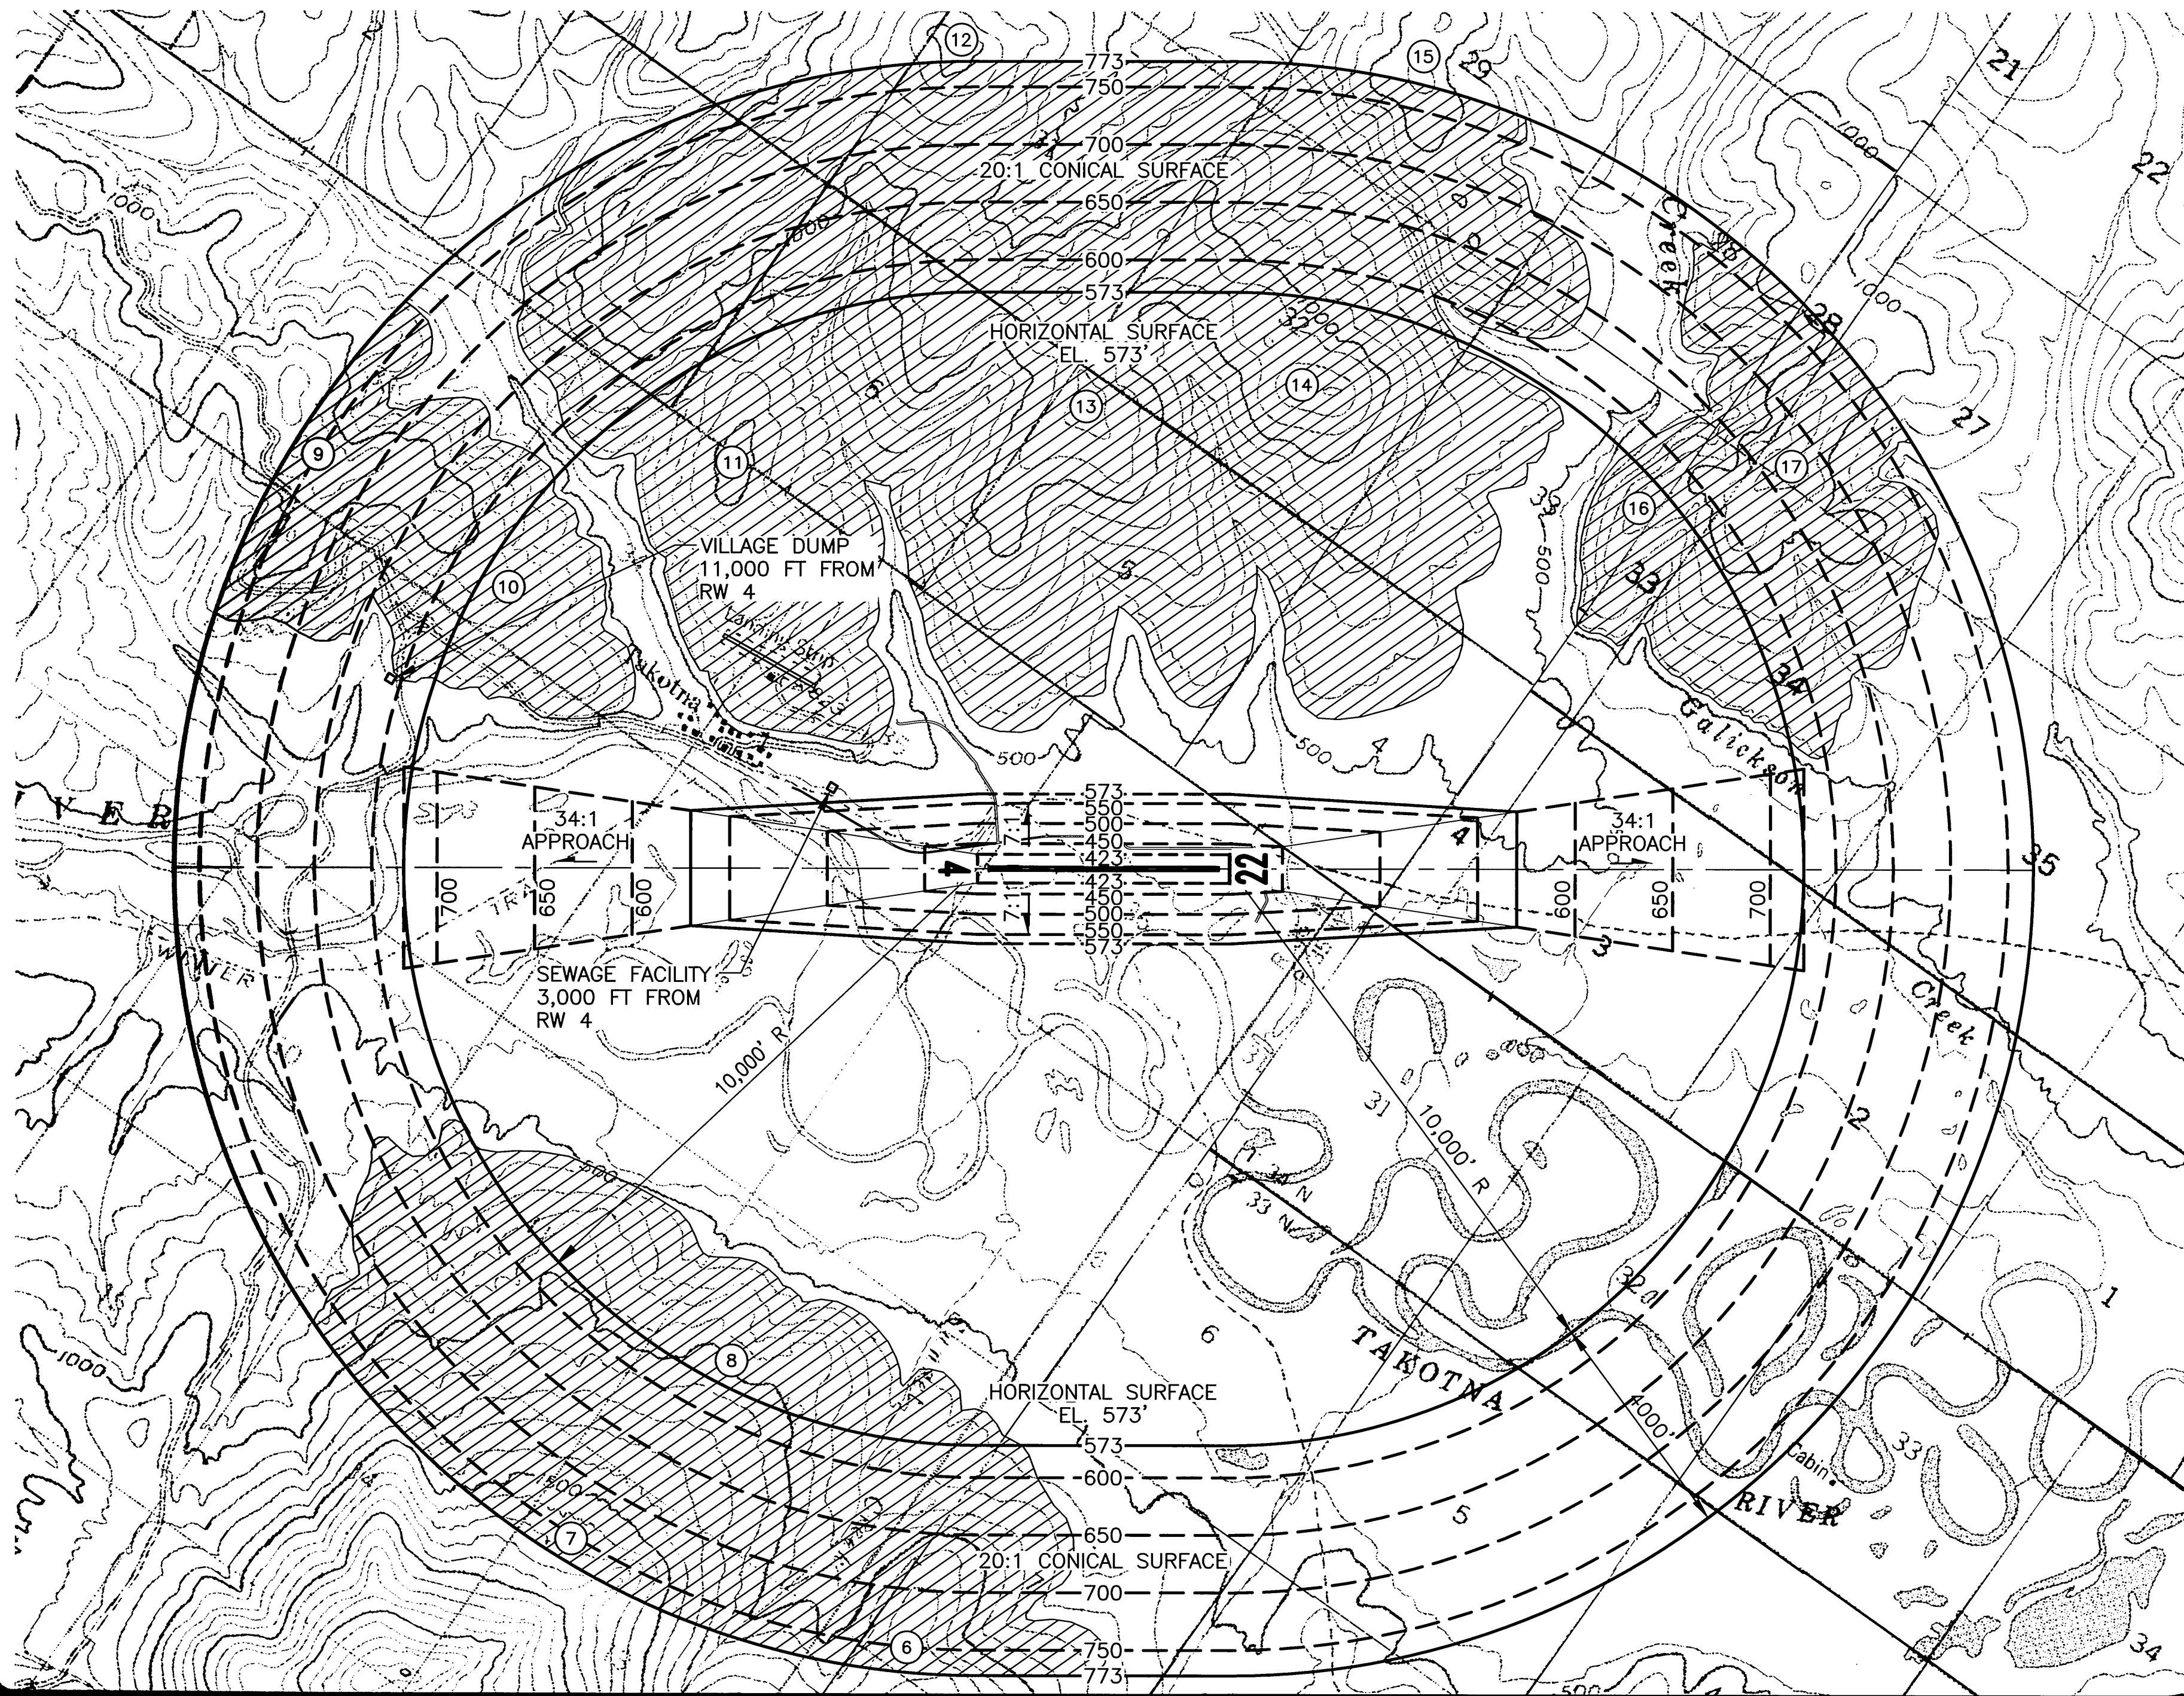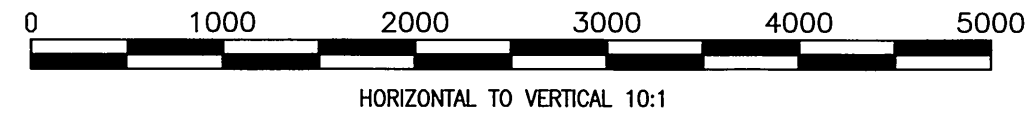

NOTES:

1. RUNWAY 4/22 PRIMARY SURFACE IS 500' FEET WIDE.
2. REFER TO INNER PORTION OF THE APPROACH SURFACE DRAWINGS FOR CLOSE IN OBSTRUCTIONS.
3. AIRPORT ELEVATION IS 423.1'.
4. APPROACH SURFACES ARE 34:1 BEGINNING 200' FROM THE THRESHOLDS.
5. BASE MAP DATA FROM USGS QUAD, IDITAROD D-1.
6. THERE ARE NO KNOWN HEIGHT RESTRICTIONS.

RUNWAY 4-22

PART 77 SURFACE OBSTRUCTIONS TABLE (OUTER PORTION)

ID #	DESCRIPTION	STATION	OFFSET	ELEVATION	SURFACE PENETRATED	SURFACE ELEVATION	AMOUNT PENETRATION	DISPOSITION	STAGE TO CORRECT
6	HIGHEST TERRAIN POINT	85+78	13,515' RT.	1250'	CONICAL	773'	477'	REMAIN	N/A
7	HIGHEST TERRAIN POINT	27+30	11,635' RT.	1650'	CONICAL	773'	877'	REMAIN	N/A
8	HIGHEST TERRAIN POINT	55+20	8,540' RT.	1000'	HORIZONTAL	573'	427'	REMAIN	N/A
9	HIGHEST TERRAIN POINT	-16+90	7,175' LT.	1200'	CONICAL	773'	427'	REMAIN	N/A
10	HIGHEST TERRAIN POINT	16+25	4,870' LT.	900'	HORIZONTAL	573'	327'	REMAIN	N/A
11	HIGHEST TERRAIN POINT	55+20	7,040' LT.	1000'	HORIZONTAL	573'	427'	REMAIN	N/A
12	HIGHEST TERRAIN POINT	95+10	14,370' LT.	1500'	CONICAL	773'	727'	REMAIN	N/A
13	HIGHEST TERRAIN POINT	116+95	8,030' LT.	1250'	HORIZONTAL	573'	677'	REMAIN	N/A
14	HIGHEST TERRAIN POINT	154+50	8,395' LT.	1400'	HORIZONTAL	573'	827'	REMAIN	N/A
15	HIGHEST TERRAIN POINT	175+70	14,095' LT.	1050'	CONICAL	773'	277'	REMAIN	N/A
16	HIGHEST TERRAIN POINT	213+30	6,270' LT.	950'	HORIZONTAL	573'	377'	REMAIN	N/A
17	HIGHEST TERRAIN POINT	239+85	6,990' LT.	1250'	CONICAL	773'	477'	REMAIN	N/A

Date Plotted: 3/28/2013 11:17 AM
 Layout Name: APL09
 File Name: \\MPCFILES\JONES\913000\DWGS\913000-TAKOTNA-ALP-AS-BUILT\913000-TAKOTNA-AS-BUILT-0113000.DWG

Designed By: JGL (USA, INC.)
 Checked By: ZMS
 Drawn By: MRM



STATE OF ALASKA
DEPARTMENT OF TRANSPORTATION
AND PUBLIC FACILITIES
CENTRAL REGION

TAKOTNA AIRPORT
 TAKOTNA, ALASKA
 AIRPORT LAYOUT PLAN
 AIRPORT AIRSPACE, 14 CFR, PART 77

DATE:
 4/19/2013
 SHEET:
 9
 OF
 10

BY	DATE	REVISION
JGL	10/24/13	AS-BUILT PER PROJECT NO 56774

Date Plotted: 3/28/2013 11:17 AM
 Layout Name: ALP10
 File Name: W:\PROJECTS\TAKOTNA AWP\ALP_2016\913000-TAKOTNA-AS-BUILT-ALP10
 USKH FILE No. 913000
 Designed By: JGL USKH, INC.
 Checked By: ZWS
 Drawn By: MRM

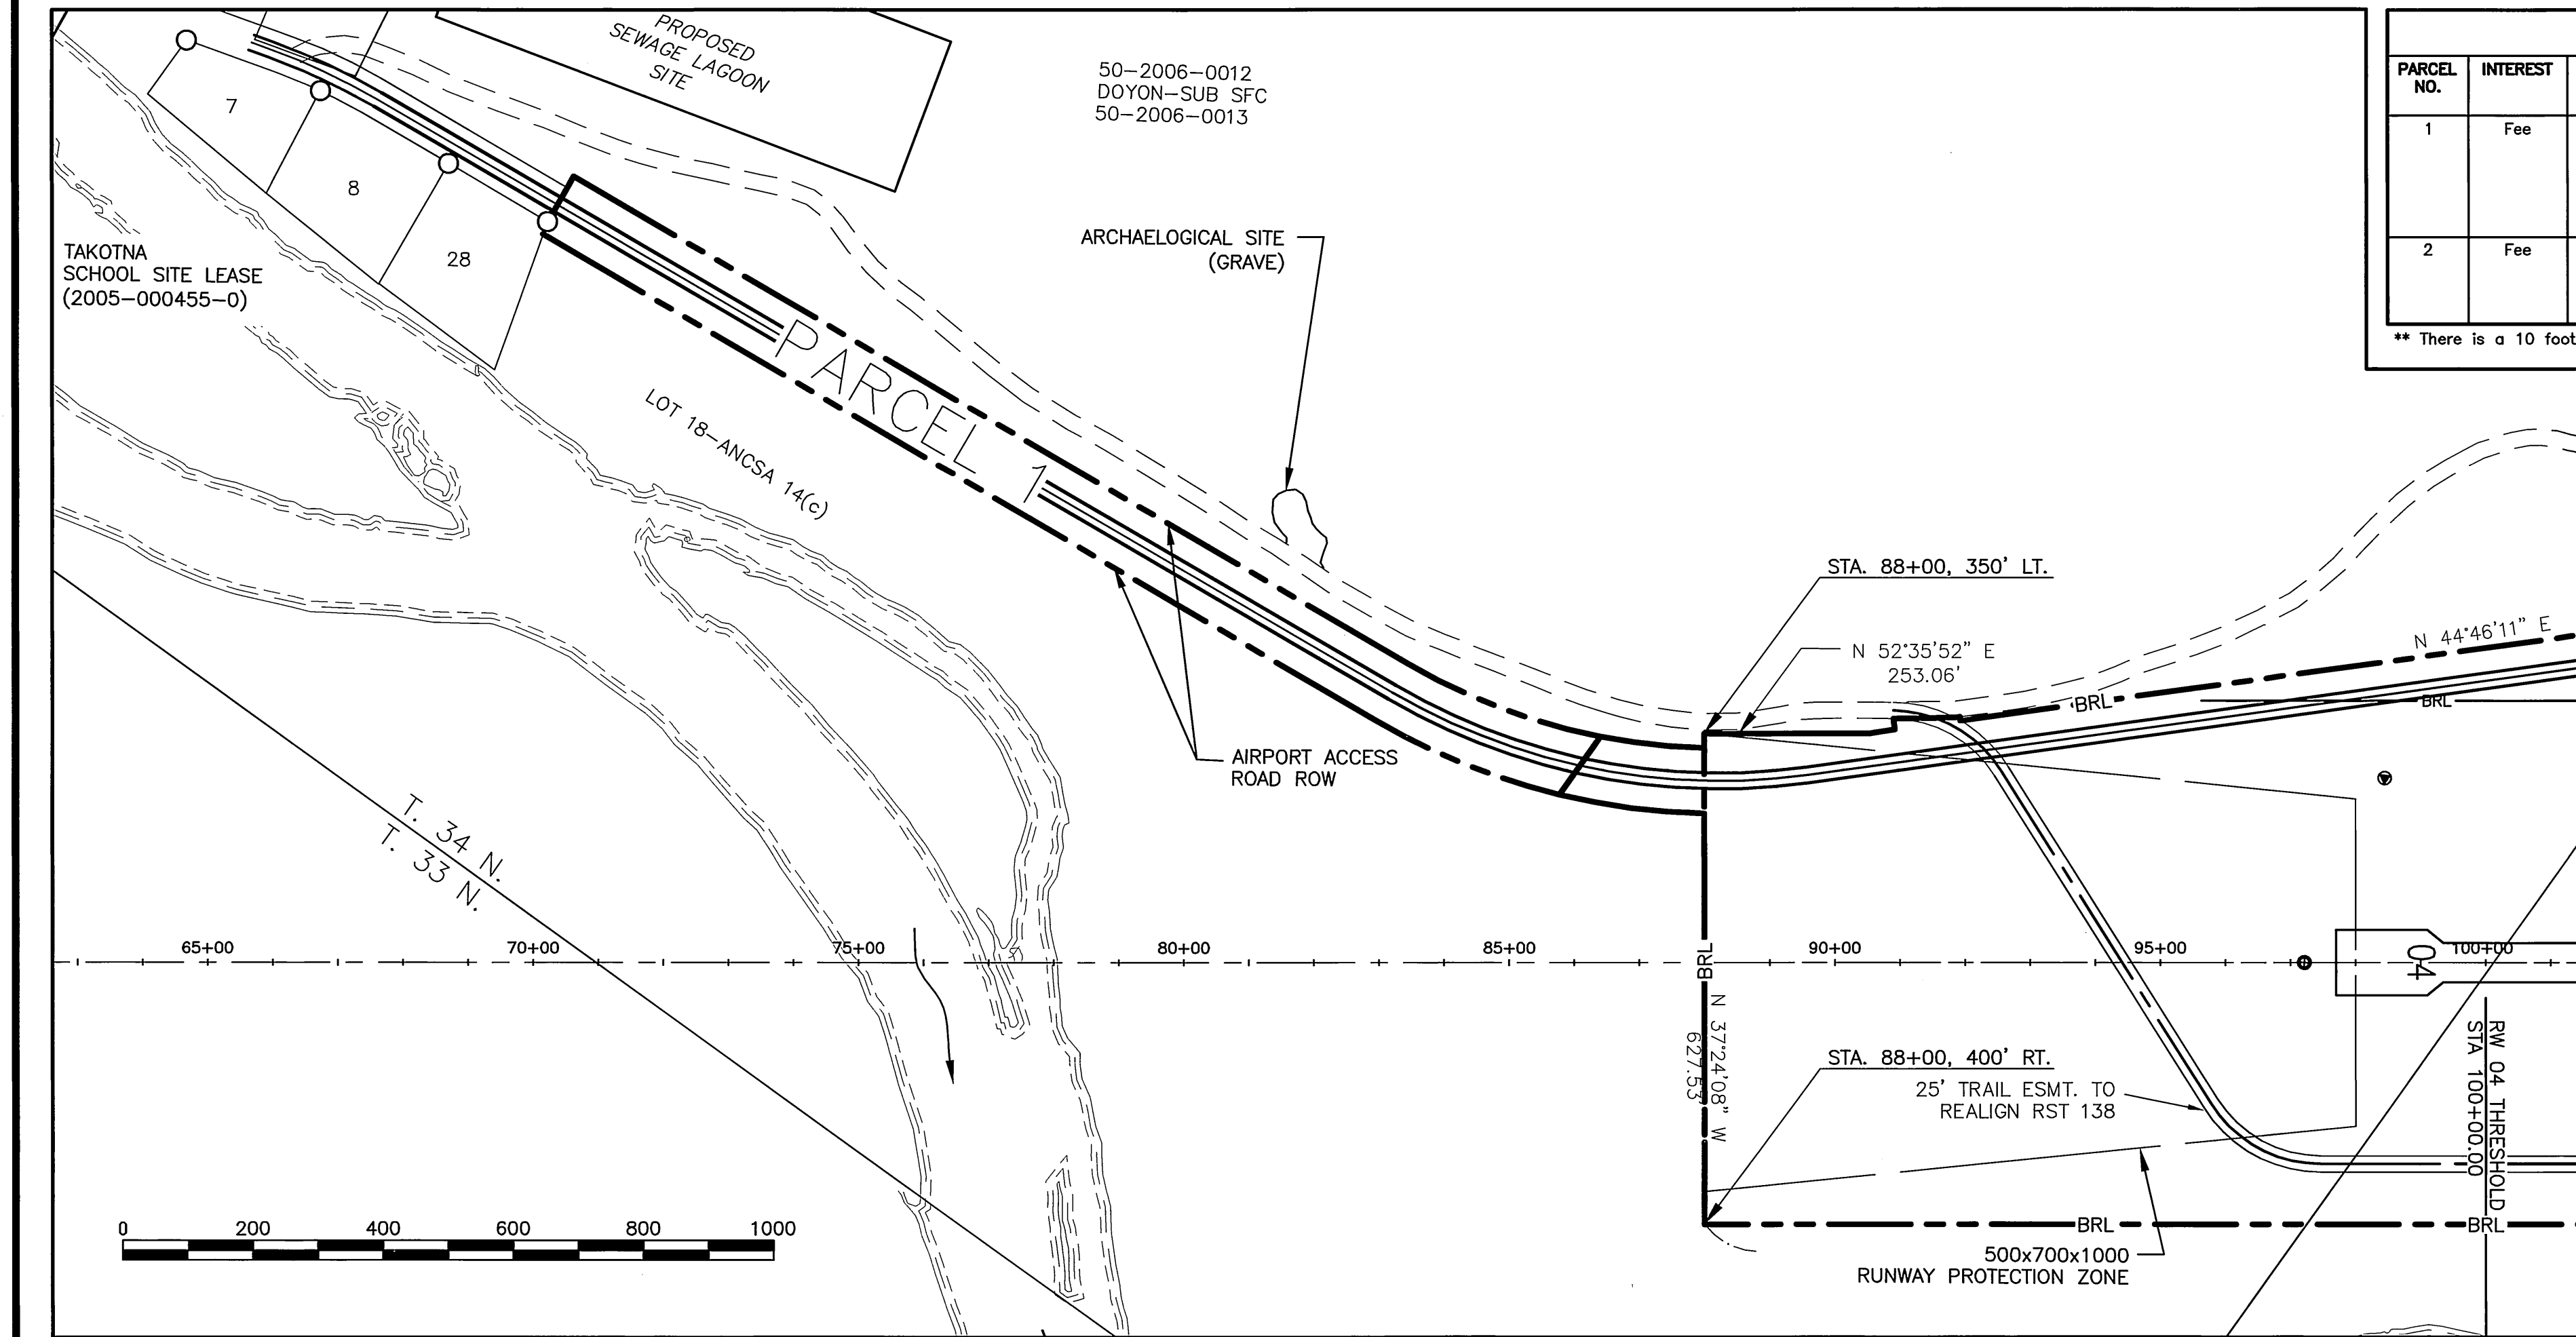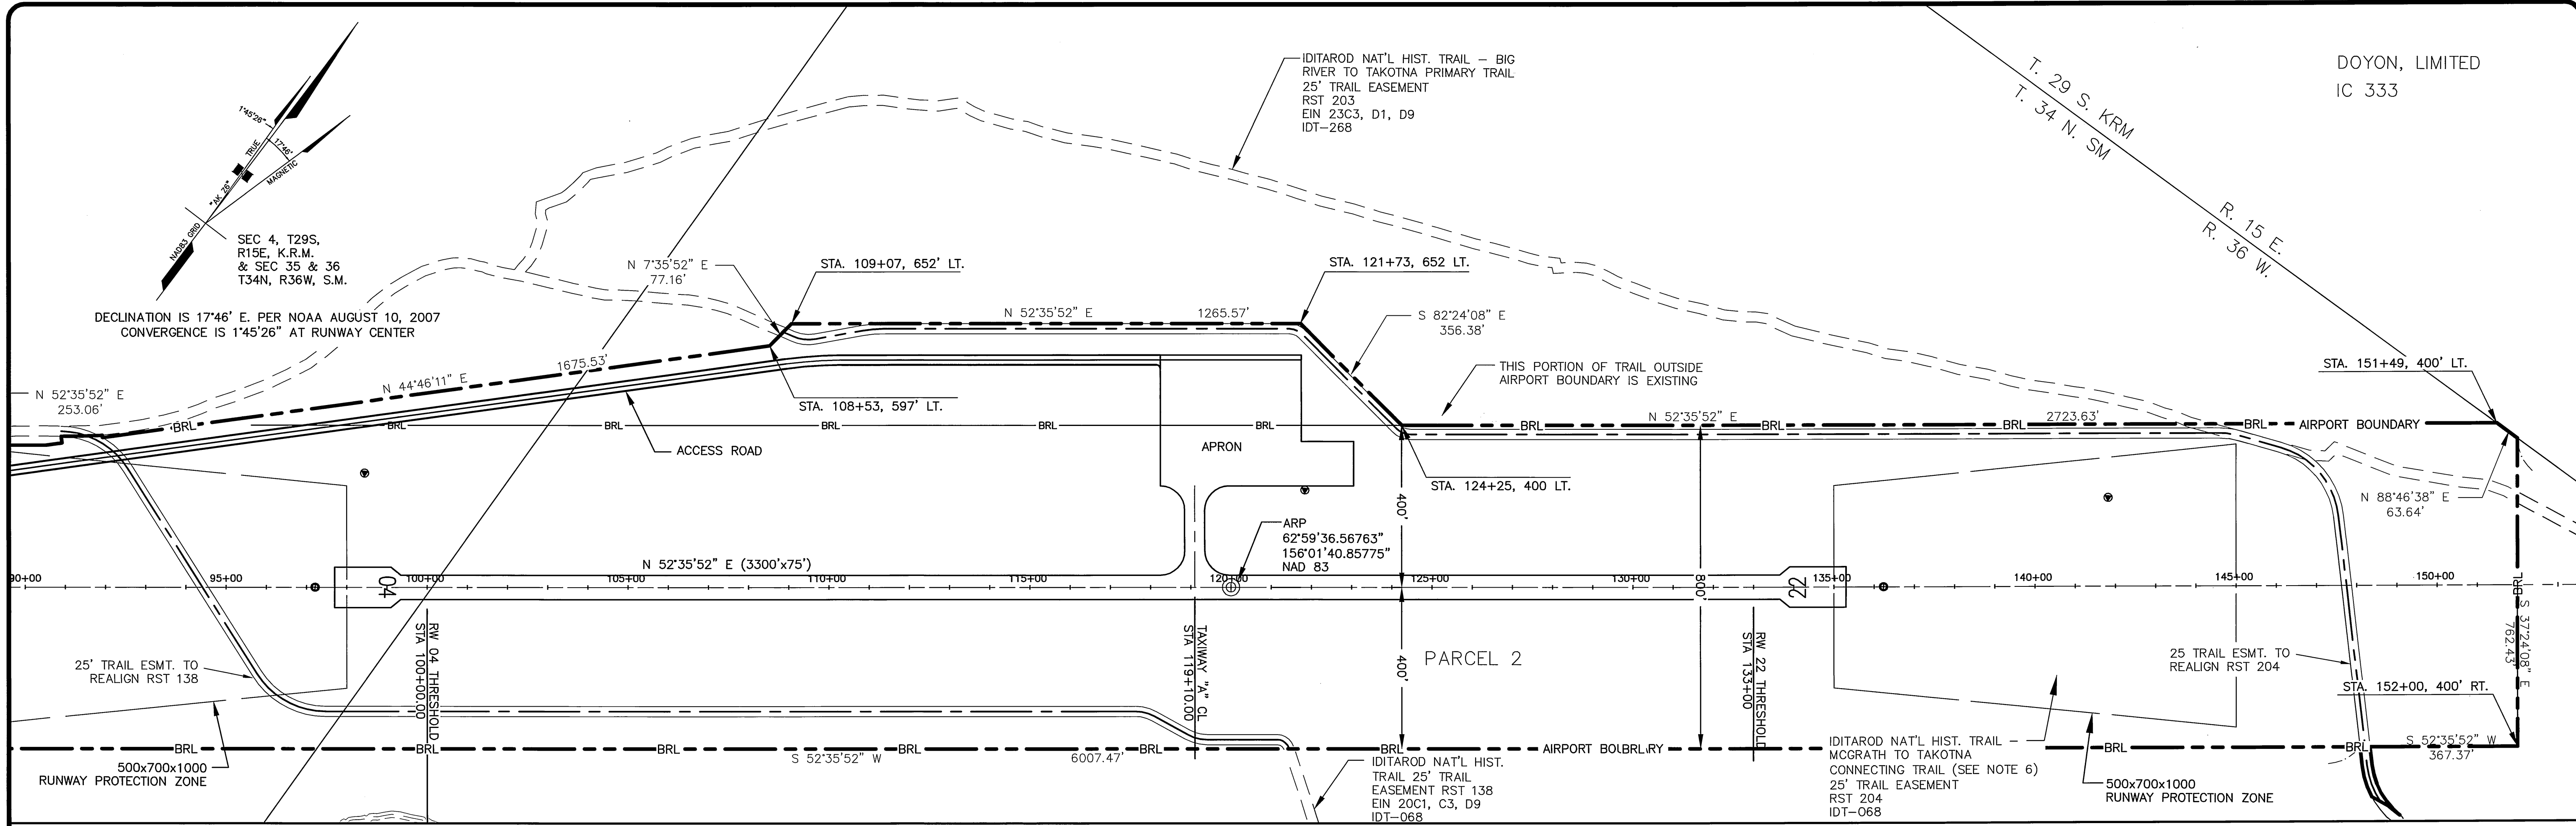


PROPERTY STATUS							
PARCEL NO.	INTEREST	GRANTOR	GRANTEE	DATE ACQUIRED	PARCEL SIZE	RECORDED DOCUMENT NO.	ACQUIRED UNDER AIP NO.
1	Fee	TAKOTNA, LIMITED - SURFACE	State of Alaska, DOT/PP	02/10/2009	4.116 Ac.	2007-000970-0 2009-000015-0	3-02-0472-001-2009
2	Fee	TAKOTNA, LIMITED - SURFACE DOYON, LIMITED - SUBSURFACE ESTATE	State of Alaska, DOT/PP	6/16/2009	125.984 Ac.	2009-000542-0 (SURFACE) 2009-000543-0 (SUBSURFACE)	3-02-0472-001-2009

** There is a 10 foot ROW Easement dedicated to United Utilities that may affect these parcels. See Bk 27, Pg 153.

- LEGEND:**
- GLO/BLM MONUMENT (RECOVERED)
 - SECONDARY MONUMENT (RECOVERED)
 - CONTROL MONUMENT
 - RUNWAY MONUMENT
 - SURVEYED SECTION/PROPERTY LINE
 - UNSURVEYED SECTION LINE
 - AIRPORT PROPERTY BOUNDARY LINE

- NOTES:**
- THE MINIMUM CLOSURE OF ALL TRAVERSES MEETS OR EXCEEDS 1:10,000.
 - THE FIELD SURVEY WAS COMPLETED IN JULY-AUGUST 2001, SEPTEMBER 2004, AND JUNE-JULY 2007 BY USKH INC.
 - ALL DIMENSIONS SHOWN ARE IN U.S. SURVEY FEET UNLESS OTHERWISE NOTED.
 - ALL GEOGRAPHIC COORDINATES SHOWN ARE NAD83 (CORS) (EPOCH 1997).
 - FOR SURVEY CONTROL INFORMATION SEE THE RECORD OF SURVEY RECORDED AS 2005-2 IN THE MT. MCKINLEY RECORDING DISTRICT.
 - THIS IS THE SAME TRAIL AS RST 138, DEPENDING ON THE YEAR THAT THE TRAIL WAS USED FOR THE IDITAROD RACE.

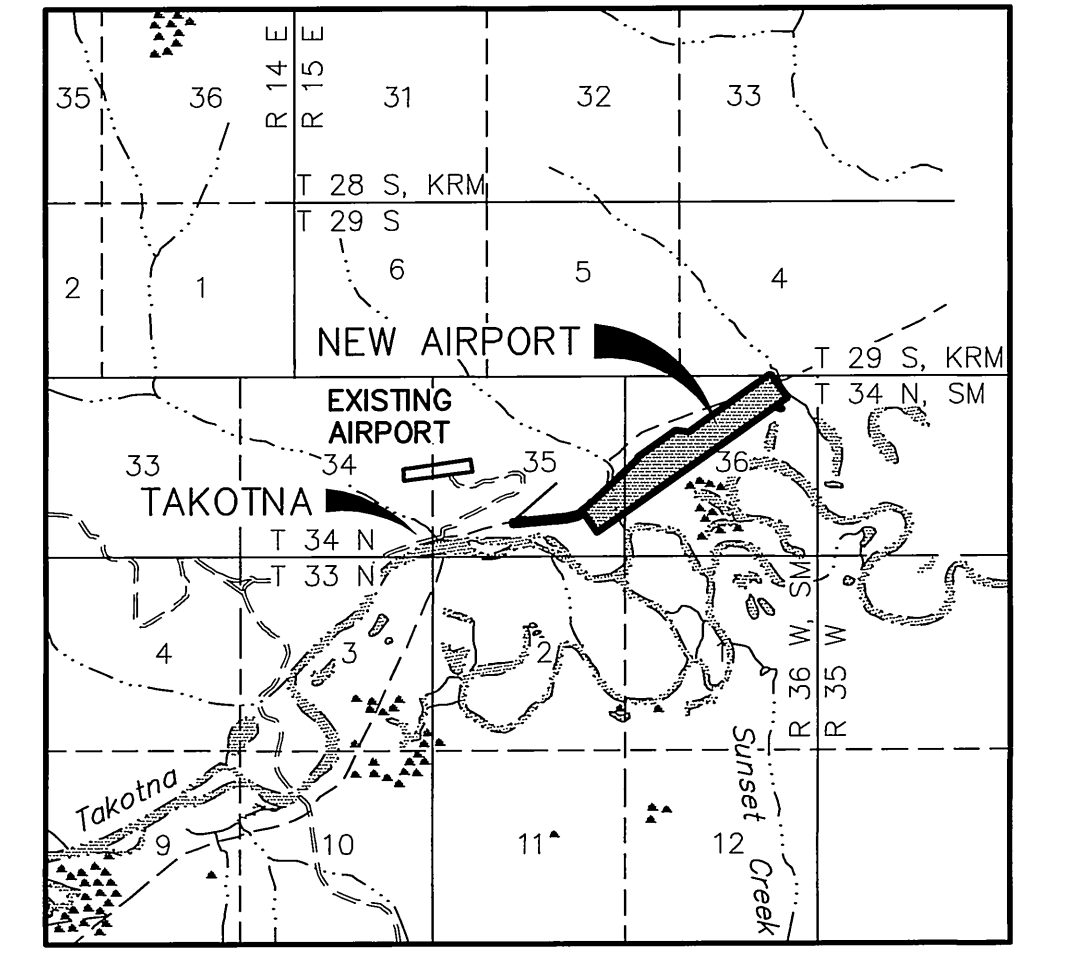

VICINITY MAP
 U.S.G.S. QUAD. IDITAROD D-1 & OPHIR A-1
 T34N, R36W, SEWARD MERIDIAN, AK
 MT. MCKINLEY RECORDING DISTRICT
 1" = 1 MILE

**STATE OF ALASKA
 DEPARTMENT OF TRANSPORTATION
 AND PUBLIC FACILITIES
 CENTRAL REGION**

TAKOTNA AIRPORT TAKOTNA, ALASKA AIRPORT LAYOUT PLAN AIRPORT PROPERTY MAP	DATE:	4/19/2013
	SHEET:	10
	OF	10
	BY	DATE
	12/14/16	AS-BUILT PROPERTY STATUS
	12/03/13	AS-BUILT TOUCHDOWN ELEVATION
JGL	10/24/13	AS-BUILT PER PROJECT NO 56774